

1993

PRESQUE ISLE COUNTY  
RECORDED

93 DEC 22 AM 10:03

COMMISSION

LAND CORNER RECORDATION CERTIFICATE  
Filing Requirement of Act 74, Mich. P.A. 1970

For corners in

PRESQUE ISLE  
(County)

Located In:

Corner Code #

1. Public Land Survey	T <u>34</u> N R <u>2</u> E	<u>I-8</u>
	T _____ R _____	_____
	T _____ R _____	_____
	T _____ R _____	_____
2. Property Controlling in Section	S _____ T _____ R _____	_____
	S _____ T _____ R _____	_____
3. Miscellaneous Property in Sec.	S _____ T _____ R _____	_____
	S _____ T _____ R _____	_____

*Janet M. Lamb*  
REGISTER OF DEEDS

Register of Deeds Stamp & File Number

4. Lot No. \_\_\_\_\_, Recorded Plat \_\_\_\_\_  
5. Private Claims \_\_\_\_\_

I, DELMER E. PORTER, in a field survey on DEC. 9, 19 93, do hereby certify that under requirements of P.A. 74, Michigan P.A. of 1970, the corner points mentioned in lines 1 and 2 above were in conformance with regulations and rules therefore as required in the current manual of survey instructions of the United States Department of the Interior, Bureau of Land Management or by a decree of a Court of Law and/or that the corner points mentioned in lines 3, 4 and 5 above were in conformance with the rules of the Michigan Board of Land Surveyors or by a Decree of a Court of Law: established, re-established, monumented, re-monumented, recovered, found as expressed below:

A	B	C	D	E	F	G	H	I	J	K	L	M
2	6	5	4	3	2	1						
3												
4	7	8	9	10	11	12						
5												
6	18	17	16	15	14	13						
7												
8	19	20	21	22	23	24						
9												
10	30	29	28	27	26	25						
11												
12	31	32	33	34	35	36						
13												

NOTE: Not more than 4 corners, all in the same town and range, may be recorded on this certificate.

A. Description of original monument and accessories and/or subsequent restoration:

I-8  
GLO NOTES  
JULY 11, 1855  
CEDAR 5" N 80° E 18 lks.  
Y. BIRCH 12" N 20° W 35 lks.

I-8 P.A. 74 FILING BY RONALD R. BISCO  
L.S. #22428, OCT. 19, 1990, PAGE 815  
LAND CORNER RECORDS  
FOUND CONCRETE MONUMENT  
S 17° E 55.72' 18" CEDAR  
S 35° W 41.02' 10" FIR  
S 75° W 50" FENCE CORNER  
N 52° E 29.94' 7" BIRCH


B. Description of corner evidence found and/or method applied in restoring or reestablishing corner:

I-8  
DEC. 8, 1993  
FOUND 4" CONCRETE MONUMENT WITH CAP #15410  
N 59° E 30.15' 8" BIRCH  
SOUTH 1' TO BEAVER POND

Ratified by Peer Group  
in accordance with P.A. 345  
Chairman *Delmer E. Porter*  
Date December 18, 1993

C. Description of monument for corner and accessories established to perpetuate locating the position of the corner:

I-8  
4" CONCRETE MONUMENT WITH CAP #15410  
N 59° E 30.15' 8" BIRCH  
N 37° W 18.33' 6" BALSAM  
N 24° E 29.26' 4" MAPLE  
N 77° E 22.79' 3" TWIN MAPLE  
\* NAILS AND TAGS #15410 USED ON WITNESSES  
PORTER'S SURVEY, P.C.

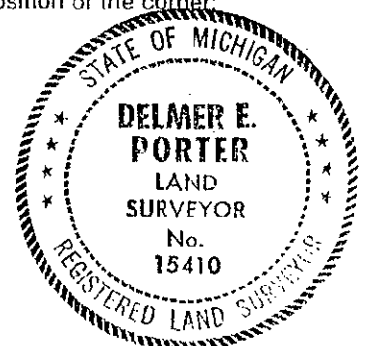

Signed by *Delmer E. Porter*

Date Dec 20, 1993

Surveyor's Michigan License No. 15410

# CORNER HISTORY RESEARCH SHEET

I-8

T34N,R2E ALLIS TOWNSHIP-NORTH PART,  
PRESQUE ISLE COUNTY, MICHIGAN.

## ACTIVITY                      MONUMENT & ACCESSORIES                      -                      COMMENTS

GLO Survey  
July 11, 1855

Cedar 5" N80°E 18 Links  
Y. Birch 12" N20°W 35 Links

Act 74 filing by  
Ronald R. Bischer #22428  
Oct. 19, 1990, Page 815  
Corner Recordation

Found Conc. Mon.  
Left Same  
S17°E 55.72' 18" Cedar  
S35°W 41.02' 10" Fir  
S75°W 50' FE Cor.  
N52°E 29.94' 7" Birch

Presque Isle  
Remonumentation  
Dec. 9, 1993

FD. 4" Conc. Mon. & Cap #15410  
and all witnesses above  
All witnesses except 8" Birch  
in Beaver Pond, replaced  
N59°E 30.15' 8" Birch  
N37°W 18.33' 6" Balsam  
N24°E 29.26' 4" Maple  
N77°E 22.79' 3" Twin Balsam  
South 1' to Beaver Pond

#5