

1993

COMMISSION

LAND CORNER RECORDATION CERTIFICATE
Filing Requirement of Act 74, Mich. P.A. 1970

PRESQUE ISLE COUNTY
RECORDED

93 DEC 22 AM 10:03

Janet M. Lamb
REGISTER OF DEEDS

For corners in

Presque Isle County Located In: _____ Corner Code # _____
(County)

1. Public Land Survey	T <u>34N</u> R <u>2E</u>	<u>I-9</u>
	T _____ R _____	_____
	T _____ R _____	_____
	T _____ R _____	_____
2. Property Controlling in Section	S _____ T _____ R _____	_____
	S _____ T _____ R _____	_____
3. Miscellaneous Property in Sec.	S _____ T _____ R _____	_____
	S _____ T _____ R _____	_____

Register of Deeds Stamp & File Number

4. Lot No. _____, Recorded Plat _____
5. Private Claims _____

	A	B	C	D	E	F	G	H	I	J	K	L
2	6	5	4	3	2	1						
3												
4	7	8	9	10	11	12						
5												
6	18	17	16	15	14	13						
7												
8	19	20	21	22	23	24						
9												
10	30	29	28	27	26	25						
11												
12	31	32	33	34	35	36						
13												

I, Delmer E. Porter in a field survey on Sept, 12, 1993, do hereby certify that under requirements of P.A. 74, Michigan P.A. of 1970, the corner points mentioned in lines 1 and 2 above were in conformance with regulations and rules therefore as required in the current manual of survey instructions of the United States Department of the Interior, Bureau of Land Management or by a decree of a Court of Law and/or that the corner points mentioned in lines 3, 4 and 5 above were in conformance with the rules of the Michigan Board of Land Surveyors or by a Decree of a Court of Law; established, re-established, monumented, re-monumented, recovered, found as expressed below:

NOTE: Not more than 4 corners, all in the same town and range, may be recorded on this certificate.

A. Description of original monument and accessories and/or subsequent restoration:

I-9 GLO Notes July 11, 1855 Y. Birch 20" N40°E 12 Links Sugar 13" S43°W 36 Links	I-9 P.A. 74 filing by Delmer E. Porter LS #15410, April 20, 1976, Page 115 Land Corner Records Found 1/2" Rod N19°E 69.52' 8" Birch N43°E 73.20' 9" Elm S48°E 50.53' Fence Corner
--	--

B. Description of corner evidence found and/or method applied in restoring or reestablishing corner:

I-9
Sept. 12, 1993
Found 1/2" Rod & Cap #15410
N16°E 69.41' 10" Birch


Ratified by Peer Group
in accordance with P.A. 345
Chairman *Delmer E. Porter*
Date December 18, 1993

C. Description of monument for corner and accessories established to perpetuate locating the position of the corner:

I-9
1/2" Rod & Cap #15410
N16°E 69.41' 10" Birch
N65°W 52.21' 5" Elm
N39°W 40.75' 8" Aspen
N01°E 33.00' 4" Concrete Monument

* Nails & tags #15410 used on witnesses.

Porter's Survey P.C.

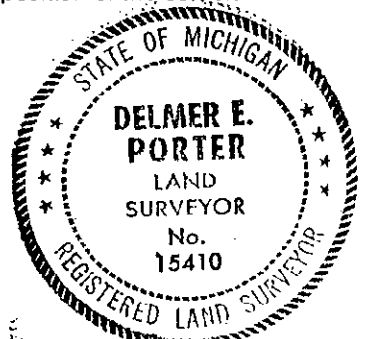

Signed by *Delmer E. Porter*
Surveyor's Michigan License No. 15410

Date Dec 20, 1993

CORNER HISTORY RESEARCH SHEET

I-9

T34N,R2E ALLIS TOWNSHIP-NORTH PART,
PRESQUE ISLE COUNTY, MICHIGAN.

ACTIVITY MONUMENT & ACCESSORIES - COMMENTS

GLO Survey
July 11, 1855

Y. Birch 20" N40°E 12 Links
Sugar 13" S43°W 36 Links

Porter's Survey
#15410, Apr.1971
While doing Section
Boundary Survey
Unrecorded

1/2" Rod & Cap #15410
N19°E 69.52' 8" Birch
N43°E 73.20' 9" Elm
S48°E 50.55' Fe. Cor.

Act 74 filing by:
Delmer E. Porter,
#15410, Apr.20, 1976
Page 115, Corner
Recordation

Fd. 1/2" Rod
Left Same
N19°E 69.52' 8" Birch
N43°E 73.20' 9" Elm
S48°E 50.53' Fe. Cor.

Act 132 Survey by:
Delmer E. Porter,
#15410 Jan.28, 1977,
Survey#6-77,
File#34R2086
Lib. 216, Pg. 404 & 402

Same as above

Act 132 Survey by;
Delmer E. Porter,
#15410, Aug.17, 1978,
Survey#129-78
File#34R2097
Lib. Pg.

Same as above.

Remonumentation
Sept. 12, 1993

Fd. 1/2" Rod & Cap #15410
N16°E 69.41' 10" Birch
Left Same
N16°E 69.41' 10" Birch
N65°W 52.21' 5" Elm
N39°W 40.75' 8" Aspen
N01°E 33.00' 4" Conc. Mon.

X³

RECORDATION

JAN 22 2001

SECTION