

LAND CORNER RECORDATION CERTIFICATE
Filing Requirement of Act 74, Mich. P.A. 1970

Janet M. Lamb
REGISTER OF DEEDS

For corners in

<u>PRESQUE ISLE</u> (County)	Located In:	Corner Code #
1. Public Land Survey	T <u>34N</u> R <u>2E</u>	<u>I-10</u>
	T _____ R _____	_____
	T _____ R _____	_____
	T _____ R _____	_____
2. Property Controlling in Section	S _____ T _____ R _____	_____
	S _____ T _____ R _____	_____
3. Miscellaneous Property in Sec.	S _____ T _____ R _____	_____
	S _____ T _____ R _____	_____

Register of Deeds Stamp & File Number

4. Lot No. _____, Recorded Plat _____
5. Private Claims _____

	A	B	C	D	E	F	G	H	I	J	K	L
2	6	5	4	3	2	1						
3												
4	7	8	9	10	11	12						
5												
6	18	17	16	15	14	13						
7												
8	19	20	21	22	23	24						
9												
10	30	29	28	27	26	25						
11												
12	31	32	33	34	35	36						
13												

I, DELMER E. PORTER, in a field survey on SEPT. 25, 19 93, do hereby certify that under requirements of P.A. 74, Michigan P.A. of 1970, the corner points mentioned in lines 1 and 2 above were in conformance with regulations and rules therefore as required in the current manual of survey instructions of the United States Department of the Interior, Bureau of Land Management or by a decree of a Court of Law and/or that the corner points mentioned in lines 3, 4 and 5 above were in conformance with the rules of the Michigan Board of Land Surveyors or by a Decree of a Court of Law; established, re-established, monumented, re-monumented, recovered, found as expressed below:

NOTE: Not more than 4 corners, all in the same town and range, may be recorded on this certificate.

A. Description of original monument and accessories and/or subsequent restoration:

I-10 GLO NOTES
JULY 11, 1855
BEECH 8" N 40° W 7 lks.
SUGAR 16" S 55° E 36 lks.

I-10 PA 74 FILING BY DELEMR E. PORTE
L.S. #15410 APRIL 20, 1976, PAGE 115
LAND CORNER RECORDS.
FOUND 1½" BAR IN ROAD CENTERLINE
RAISED WITH ½" ROD & CAP #5410
WEST 34.06' FENCE CORNER
EAST 32.82' FENCE CORNER
N 40° E 63.38' 6" NORWAY PINE


B. Description of corner evidence found and/or method applied in restoring or reestablishing corner:

I -10
SEPT. 25, 1993
FOUND ½" ROD & CAP #15410
N 35° E 74.63' 18" NORWAY
WEST 34.06' FENCE CORNER
EAST 32.82' FENCE CORNER

Ratified by Peer Group
in accordance with P.A. 945
Chairman *Delmer E. Porter*
Date December 18, 1993

C. Description of monument for corner and accessories established to perpetuate locating the position of the corner:

I-10
½" ROD & CAP #15410
N 35° E 74.63' 18" NORWAY
N 66° E 44.50' 16" NORWAY
S 39° E 65.10' CLUMP OF 5" MAPLES
S 59° W 81.54' 14" MAPLE
* NAILS AND TAGS #15410 USED ON WITNESSES
PORTER'S SURVEY, P.C.

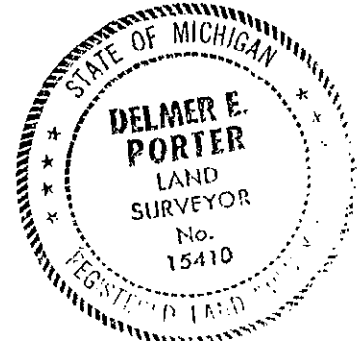

Signed by *Delmer E. Porter*

Date Dec 20, 1993

Surveyor's Michigan License No. 15410

CORNER HISTORY RESEARCH SHEET

I-10

T34N,R2E ALLIS TOWNSHIP-NORTH PART,
PRESQUE ISLE COUNTY, MICHIGAN.

ACTIVITY MONUMENT & ACCESSORIES - COMMENTS

GLO Survey July 11, 1855	Beech 8" N40°W 7 Links Sugar 16" S55°E 36 Links	
Act 74 filing by: Delmer E. Porter #15410, Apr. 20, 1976 Page 115, Corner Recordation	Fd. 1 1/2" Bar in Road CenterLine and in line with fences East and West raised w/ 1/2" Rod & Cap #15410 Due West 34.06' Fe. Cor. Due East 32.82' Fe. Cor. N40°E 63.38' 6" Norway	
Act 132 Survey by: Delmer E. Porter #15410, Jan. 28, 1977, Survey#6-77, File#34R2086 Lib.216, Pg.402	Same as above	
Act 132 Survey by: Delmer E. Porter #15410, Aug.17, 1978, Survey#129-78, File#34R2097 Lib.226, Pg.479	Same as above	
Act 132 Survey by: Delmer E. Porter #15410, Sept. 10.1981, Survey#82-81, File#34R2120 Lib.244, Pg.656	Fd. Same as above	
Act 132 Survey by: Delmer E. Porter #15410, Mar.22, 1984, Survey#12-84, File#34R2146 Lib.256 Pg. 468	Same as above	
Remonumentation Sept. 25, 1993	Fd. 1/2" Rod & Cap #15410 N35°E 74.63' 18" Norway Due West 34.06' Fe. Cor Due East 32.82' Fe. Cor. Left Same N35°E 74.63' 18" Norway N66°E 44.50' 16" Norway S39°E 65.10' Clump of 5" Maples S59°W 81.54' 14" Maple	

M,
X