

1993

PRESQUE ISLE COUNTY
RECORDED

93 DEC 22 AM 10:04

COMMISSION

LAND CORNER RECORDATION CERTIFICATE
Filing Requirement of Act 74, Mich. P.A. 1970

Janet M. Lamb
REGISTER OF DEEDS

For corners in

PRESQUE ISLE
(County)

Located In:

Corner Code #

- | | | | | | |
|---------------------------------------|---|-----|---|----|------|
| 1. Public Land Survey | T | 34N | R | 2E | I-11 |
| | T | | R | | |
| | T | | R | | |
| | T | | R | | |
| 2. Property Controlling
in Section | S | | T | R | |
| | S | | T | R | |
| 3. Miscellaneous
Property in Sec. | S | | T | R | |
| | S | | T | R | |

Register of Deeds Stamp & File Number

4. Lot No. _____, Recorded Plat _____
5. Private Claims _____

I, DELMER E. PORTER, in a field survey on SEPT. 25, 19 93, do hereby certify that under requirements of P.A. 74, Michigan P.A. of 1970, the corner points mentioned in lines 1 and 2 above were in conformance with regulations and rules therefore as required in the current manual of survey instructions of the United States Department of the Interior, Bureau of Land Management or by a decree of a Court of Law and/or that the corner points mentioned in lines 3, 4 and 5 above were in conformance with the rules of the Michigan Board of Land Surveyors or by a Decree of a Court of Law; established, re-established, monumented, re-monumented, recovered, found as expressed below:

NOTE: Not more than 4 corners, all in the same town and range, may be recorded on this certificate.

A	B	C	D	E	F	G	H	I	J	K	L	M
2	6	5	4	3	2	1						
3												
4	7	8	9	10	11	12						
5												
6	18	17	16	15	14	13						
7												
8	19	20	21	22	23	24						
9												
10	30	29	28	27	26	25						
11												
12	31	32	33	34	35	36						
13												

A. Description of original monument and accessories and/or subsequent restoration:

I-11 GLO NOTES
 JULY 11, 1855
 SUGAR 6" N 76° W 17½ lks.
 SUGAR 17" S 38° E 36 lks.

I-11 P.A. 74 FILING BY DELMER E. PORTER
 L.S. #15410, APRIL 20, 1976, PAGE 115
 LAND CORNER RECORDS, SET BOAT SPIKE
 FROM ESTABLISHED FENCE CORNERS
 WEST 33.56' FENCE CORNER
 EAST 33.50' FENCE CORNER
 S 81° E 68.80' 6" MAPLE


B. Description of corner evidence found and/or method applied in restoring or reestablishing corner:

I-11
 SEPT. 25, 1993
 FOUND BOAT SPIKE
 WEST 33.56' FENCE CORNER
 EAST 33.58' FENCE CORNER
 REPLACED BOAT SPIKE WITH
 ½" ROD & LLS CAP #15410

**Ratified by Peer Group
 in accordance with P.A. 345**
 Chairman *Delmer E. Porter*
 Date December 18, 1993

C. Description of monument for corner and accessories established to perpetuate locating the position of the corner:

I-11
 ½" ROD & CAP #15410
 S 76° E 65.20' 8" TWIN BASSWOOD
 S 47° E 65.45' 10" MAPLE
 S 78° W 95.53' 8" ELM
 N 34° W 111.48' 20" BASSWOOD
 * NAILS AND TAGS #15410 USED ON WITNESSES
 PORTER'S SURVEY, P.C.

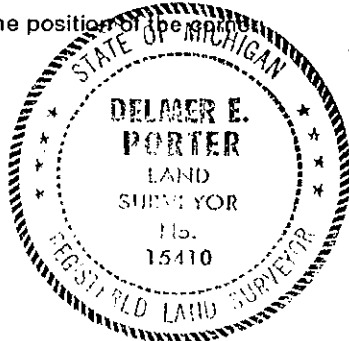

Signed by *Delmer E. Porter*
 Surveyor's Michigan License No. 15410

Date Dec 20, 1993

CORNER HISTORY RESEARCH SHEET

I-11

T34N,R2E ALLIS TOWNSHIP-NORTH PART,
PRESQUE ISLE COUNTY, MICHIGAN.

ACTIVITY	MONUMENT & ACCESSORIES	COMMENTS
----------	------------------------	----------

GLO Survey
July 11, 1855

Sugar 6" N76°W 17 1/2 Link
Sugar 17" S38°E 36 Link

Act 74 filing by:
Delmer E. Porter
#15410, Apr.20, 1976
Page 115, Corner
Recordation

Set Boat Spike from
Established Fe. Cor.
Due West 33.56' Fe. Cor.
Due East 33.50' Fe. Cor.
S81°E 68.80' 6" Maple

Act 132 Survey by:
Delmer E. Porter
#15410, Sept.10, 1981
File#34R2120
Survey#82-81,
Lib.244, Pg.658

Same as above

Act 132 Survey by:
Delmer E. Porter
#15410, Aug.11, 1983,
Survey#82-83,
File#34R2136
Lib.252, Pg.252

Same as above

Remonumentation
Sept.25, 1993

Fd. Boat Spike
Due West 33.56' Fe. Cor.
Due East 33.58' Fe. Cor.
Replaced with 1/2" Rod & Cap
S76°E 65.20' 8" Twin Basswood
S47°E 65.45' 10" Maple
S78°W 95.53' 8" Elm
N34°W 111.48' 20" Basswood

#3