

1993

COMMISSION

PRESQUE ISLE COUNTY  
RECORDED

93 DEC 22 AM 10:04

LAND CORNER RECORDATION CERTIFICATE  
Filing Requirement of Act 74, Mich. P.A. 1970

*Janet M. Lamb*  
REGISTER OF DEEDS

For corners in

<u>Presque Isle</u> <small>(County)</small>	Located In:	Corner Code #
1. Public Land Survey	T <u>34N</u> R <u>2E</u>	<u>I-12</u>
	T _____ R _____	_____
	T _____ R _____	_____
	T _____ R _____	_____
2. Property Controlling in Section	S _____ T _____ R _____	_____
	S _____ T _____ R _____	_____
3. Miscellaneous Property in Sec.	S _____ T _____ R _____	_____
	S _____ T _____ R _____	_____

Register of Deeds Stamp & File Number

4. Lot No. \_\_\_\_\_, Recorded Plat \_\_\_\_\_  
5. Private Claims \_\_\_\_\_

A	B	C	D	E	F	G	H	I	J	K	L	M
2	6	5	4	3	2	1						
3												
4	7	8	9	10	11	12						
5												
6	18	17	16	15	14	13						
7												
8	19	20	21	22	23	24						
9												
10	30	29	28	27	26	25						
11												
12	31	32	33	34	35	36						
13												

I, Delmer E. Porter in a field survey on Sept. 25, 1993, do hereby certify that under requirements of P.A. 74, Michigan P.A. of 1970, the corner points mentioned in lines 1 and 2 above were in conformance with regulations and rules theretofore as required in the current manual of survey instructions of the United States Department of the Interior, Bureau of Land Management or by a decree of a Court of Law and/or that the corner points mentioned in lines 3, 4 and 5 above were in conformance with the rules of the Michigan Board of Land Surveyors or by a Decree of a Court of Law; established, re-established, monumented, re-monumented, recovered, found as expressed below:

**NOTE: Not more than 4 corners, all in the same town and range, may be recorded on this certificate.**

A. Description of original monument and accessories and/or subsequent restoration:

I-12 GLO Notes July 11, 1855 Beech 12" S47°W 13 Links Beech 14" S58°E 17½ Links	I-12 P.A. 74 filing by Delmer E. Porter LS #15410, April 20, 1976, Page 117 Land Corner Records Found 3/4" Pipe N29°W 31.22' 10" Ash S32°E 14.70' 22" Maple S42°W 29.75' 10" Elm
---	---


B. Description of corner evidence found and/or method applied in restoring or reestablishing corner:

I-12  
Sept. 25, 1993  
Found 3/4" Pipe  
S32°E 14.70' 24" Stump  
N20°W 31.75' 12" Ash  
Placed Cap #15410 in Pipe

Ratified by Peer Group  
in accordance with P.A. 345  
Chairman *Delmer E. Porter*  
Date December 18, 1993

C. Description of monument for corner and accessories established to perpetuate locating the position of the corner:

I-12  
3/4" Pipe & Cap #15410  
N40°E 115.23' 12" Aspen  
N20°W 31.75' 12" Aspen  
S76°W 27.70' 10" MAPLE  
S69°E 49.48' 4" Balsam  
\* Nails & tags #15410 used on witnesses.

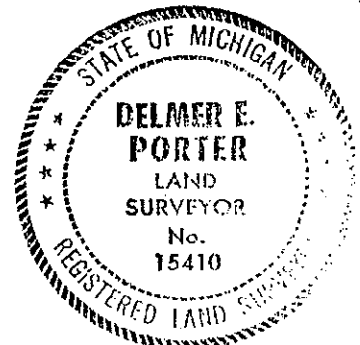

Porter's Survey P.C.

Signed by *Delmer E. Porter*

Date Dec 20, 1993

Surveyor's Michigan License No. \_\_\_\_\_

# CORNER HISTORY RESEARCH SHEET

I-12

T34N,R2E ALLIS TOWNSHIP-NORTH PART,  
PRESQUE ISLE COUNTY, MICHIGAN.

## ACTIVITY MONUMENT & ACCESSORIES - COMMENTS

GLO Survey July 11, 1855	Beech 12" S47°W 13 Link Beech 14" S58°E 17 1/2 Link
Survey by: Porter's Survey #15410, Feb.14, 1970 Job#4-70 Not Recorded	Same as below
Act 74 filing by: Delmer E. Porter #15410, Apr.20, 1976 Page 117, Corner Recordation	Fd. 3/4" Pipe Left Same N29°W 31.22' 10"Ash S32°E 14.70' 22" Maple — 14.70' S42°W 29.75' 10" Elm
Act 132 Survey by: Delmer E. Porter #15410, Aug.11, 1983, Survey#82-83, File#34R2136 Lib.252, Pg.252	Same as below PART A
Remonumentation Sept.25, 1993	Fd. 3/4" Pipe. Elm gone S32°E 14.70' 24" Stump (Fd.) N20°W 31.75' 12" Ash (Fd.) Left Same N40°E 115.23' 1/2" Aspen (Put RLS Cap inside #154L0) N20°W 31.75' 12" Aspen S76°W 27.70' 10" Maple S69°E 49.48' 4" Balsam

1/1  
X

RESEARCH &  
RECORDATION  
JAN 22 2001  
SECTION