

1993

COMMISSION

LAND CORNER RECORDATION CERTIFICATE
Filing Requirement of Act 74, Mich. P.A. 1970

PRESQUE ISLE COUNTY
RECORDED

93 DEC 22 AM 10:04

Jane M. Lamb
REGISTER OF DEEDS

For corners in
PRESQUE ISLE
(County)

Located In:

Corner Code #

- 1. Public Land Survey T 34N R 2E I-13
- T _____ R _____
- T _____ R _____
- T _____ R _____
- 2. Property Controlling S _____ T _____ R _____
- in Section S _____ T _____ R _____
- 3. Miscellaneous S _____ T _____ R _____
- Property in Sec. S _____ T _____ R _____

Register of Deeds Stamp & File Number

- 4. Lot No. _____, Recorded Plat _____
- 5. Private Claims _____

	A	B	C	D	E	F	G	H	I	J	K	L	M
2	6		5		4		3		2				
3													
4	7		8		9		10		11		12		
5													
6	10		17		16		15		14		13		
7													
8	19		20		21		22		23		24		
9													
10	30		29		28		27		26		25		
11													
12	31		32		33		34		35		36		
13													

I, DELMER E. PORTER in a field survey on SEPT. 13, 1993, do hereby certify that under requirements of P.A. 74, Michigan P.A. of 1970, the corner points mentioned in lines 1 and 2 above were in conformance with regulations and rules therefore as required in the current manual of survey instructions of the United States Department of the Interior, Bureau of Land Management or by a decree of a Court of Law and/or that the corner points mentioned in lines 3, 4 and 5 above were in conformance with the rules of the Michigan Board of Land Surveyors or by a Decree of a Court of Law; established, re-established, monumented, re-monumented, recovered, found as expressed below:

NOTE: Not more than 4 corners, all in the same town and range, may be recorded on this certificate.

A. Description of original monument and accessories and/or subsequent restoration:

I-13 GLO NOTES
JULY 3, 1855
SUGAR 6" S 37° E 48 lks.
SUGAR 12" S 60° W 47 lks.

I-13
P.A. 74 FILING BY DELMER E. PORTER
L.S. #15410 APRIL 20, 1976 PAGE 116
LAND CORNER RECORDS
SET 1/2" ROD & CAP FROM FENCE CORNER
NORTH 33.00' FENCE CORNER
N 16° E 32.06' 4" ASPEN
N 56° W 88.05' 8" APPLE


B. Description of corner evidence found and/or method applied in restoring or reestablishing corner:

I-13
SEPT. 13, 1993
FOUND 1/2" ROD & CAP #15410
NORTH 33.00' FENCE CORNER
N 54° W 88.09' 6" TRIPLE APPLE

Ratified by Peer Group
in accordance with P.A. 345
Chairman *Delmer E. Porter*
Date December 18, 1993

C. Description of monument for corner and accessories established to perpetuate locating the position of the corner:

I-13
1/2" ROD & CAP #15410
N 11° E 35.05' 10" ASPEN
N 54° W 88.09' 6" TRIPBE APPLE
S 55° E 31.69' 6" APPLE
S 77° W 206.47' 8" RED PINE
* NAILS AND TAGS #15410 USED ON WITNESSES
PORTER'S SURVEY, P.C.

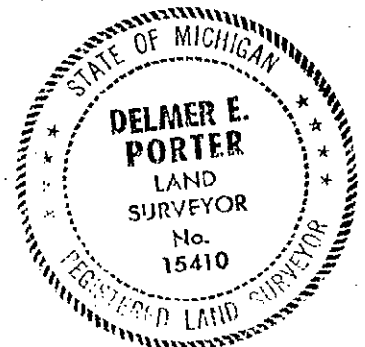

Signed by *Delmer E. Porter*

Date Dec 20, 1993

Surveyor's Michigan License No. 15410

CORNER HISTORY RESEARCH SHEET

I-13

T34N,R2E ALLIS TOWNSHIP-NORTH PART,
PRESQUE ISLE COUNTY, MICHIGAN.

ACTIVITY MONUMENT & ACCESSORIES - COMMENTS

GLO Survey
July 3, 1855

Sugar 6" S37°E 48 Links
Sugar 12" S60°W 47 Links

Act 74 filing by:
Delmer E. Porter,
#15410, April 20, 1976,
Page 116, Corner
Recordation

Set 1/2" Rod & Cap #15410
Off Fe. Cor. to North
Due North 33.00' Fe. Cor.
N16°E 32.06' 4" Aspen
N56°W 88.05' 8" Apple

Remonumentation
Sept. 13, 1993

Fd. 1/2" Rod & Cap #15410
North 33.00' Fe. Cor.
N54°W 88.09' 6" Tri. Apple
Left Same
N11°E 35.05' 10" Aspen
N54°W 88.09' 6" Tri. Apple
S55°E 31.69' 6" Apple
S77°W 206.47' R. Pine

#5