

PRESQUE ISLE COUNTY
RECORDED

93 DEC 20 PM 4: 50

LAND CORNER RECORDATION CERTIFICATE
Filing Requirement of Act 74, Mich. P.A. 1970

For corners in

<u>PRESQUE ISLE</u> <small>(County)</small>	Located In:	Corner Code <u>J-3</u>
1. Public Land Survey	T <u>34N</u> R <u>2E</u>	<u>J-3</u>
	T _____ R _____	_____
	T _____ R _____	_____
	T _____ R _____	_____
2. Property Controlling in Section	S _____ T _____ R _____	_____
	S _____ T _____ R _____	_____
3. Miscellaneous Property in Sec.	S _____ T _____ R _____	_____
	S _____ T _____ R _____	_____

Janet M. Lamb
REGISTER OF DEEDS

LIBER **307** PAGE **960**

Register of Deeds Stamp & File Number

4. Lot No. _____, Recorded Plat _____
5. Private Claims _____

I, Ronald R. Bischer, in a field survey on September 20, 19 93, do hereby certify that under requirements of P.A. 74, Michigan P.A. of 1970, the corner points mentioned in lines 1 and 2 above were in conformance with regulations and rules therefore as required in the current manual of survey instructions of the United States Department of the Interior, Bureau of Land Management or by a decree of a Court of Law and/or that the corner points mentioned in lines 3, 4 and 5 above were in conformance with the rules of the Michigan Board of Land Surveyors or by a Decree of a Court of Law; established, re-established, monumented, re-monumented, recovered, found as expressed below:

A	B	C	D	E	F	G	H	I	J	K	L	M
2	6	5	4	3	2	1						
3												
4	7	8	9	10	11	12						
5												
6	18	17	16	15	14	13						
7												
8	19	20	21	22	23	24						
9												
10	30	29	28	27	26	25						
11												
12	31	32	33	34	35	36						
13												

NOTE: Not more than 4 corners, all in the same town and range, may be recorded on this certificate.

A. Description of original monument and accessories and/or subsequent restoration:

J-3
1855 Resurvey - Geo. H. Cannon (July)
Set Wood Post
7" Spruce N55°W 12 links
7" Spruce S10°E 26 links
1978 - Delmar E. Porter (Remonumentation)
Found square Cedar stake next to 6" Balsam blazed on 4 sides and probable O.B.T. stumps

Set Concrete Monument w/Brass Cap
N19°E 14.22' 4" Cedar
S35°E 11.76' 7" Cedar
S75°W 13.09' 4" Cedar
Recorded on Page 319, Land Recordation, November 29, 1978.


B. Description of corner evidence found and/or method applied in restoring or reestablishing corner:

J-3
Found Presque Isle County Remonumentation Monument
N19°E 14.22' 6" Cedar
S39°E 11.76' 10" Cedar
S70°W 13.09' 6" Cedar

SURVEY &
REMONUMENTATION

1993

COMMISSION

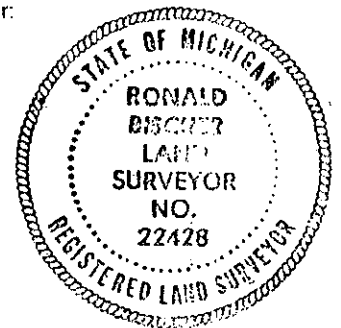

C. Description of monument for corner and accessories established to perpetuate locating the position of the corner:

J-3
Presque Isle County Remonumentation Monument
N19°E 14.22' 6" Cedar
S39°E 11.76' 10" Cedar
S70°W 13.09' 6" Cedar
N16°W 5.10' 8" Balsam

Ratified by Peer Group
in accordance with P.A. 345
Chairman *Delmar E. Porter*
Date December 7, 1995

Signed by Ronald R. Bischer

Date 12-13-93

Surveyor's Michigan License No. 22428

J-3 Corner, Section 2, 11, Township 34N Range 2E

<u>Activity</u>	<u>Monument & Accessories</u>	<u>Notes</u>
1855 Resurvey Geo. H. Cannon	Set Wood Post 7" Spruce N55°W 12 links 7" Spruce S10°E 26 links	
1978 Remonumentation Delmar E. Porter #15410	Set Concrete Monument w/Brass Cap Set three witnesses Recorded on Page 319, Land Recordation, November 29, 1978	Found square Cedar stake next to 6" Balsam blazed on 4 sides and probable O.B.T. stumps.
1993 Remonumentation Ronald R. Bischer #22428	Found Concrete Monument w/Brass Cap N19°E 14.22' 6" Cedar found nail w/tag #15410 S39°E 11.76' 10" Cedar found nail w/tag #15410 S70°W 13.09' 6" Cedar found nail w/tag #15410 N16°W 5.10' 8" Balsam	

/