

PRESQUE ISLE COUNTY
RECORDED

93 DEC 20 PM 4: 50

LAND CORNER RECORDATION CERTIFICATE
Filing Requirement of Act 74, Mich. P.A. 1970

For corners in

PRESQUE ISLE
(County)

Located In:

Corner Code #

- | | | |
|---------------------------------------|--------------------------|------------|
| 1. Public Land Survey | T <u>34N</u> R <u>2E</u> | <u>J-7</u> |
| | T _____ R _____ | _____ |
| | T _____ R _____ | _____ |
| | T _____ R _____ | _____ |
| 2. Property Controlling
in Section | S _____ T _____ R _____ | _____ |
| | S _____ T _____ R _____ | _____ |
| 3. Miscellaneous
Property in Sec. | S _____ T _____ R _____ | _____ |
| | S _____ T _____ R _____ | _____ |

Jane M. Lamb
REGISTER OF DEEDS

LIBER 307 PAGE 963

Register of Deeds Stamp & File Number

4. Lot No. _____, Recorded Plat _____
5. Private Claims _____

	A	B	C	D	E	F	G	H	I	J	K	L	M
2	6		5		4		3		2		1		
3													
4	7		8		9		10		11		12		
5													
6	18		17		16		15		14		13		
7													
8	19		20		21		22		23		24		
9													
10	30		29		28		27		26		25		
11													
12	31		32		33		34		35		36		
13													

I, Ronald R. Bischer, in a field survey on September 20, 19 93, do hereby certify that under requirements of P.A. 74, Michigan P.A. of 1970, the corner points mentioned in lines 1 and 2 above were in conformance with regulations and rules therefore as required in the current manual of survey instructions of the United States Department of the Interior, Bureau of Land Management or by a decree of a Court of Law and/or that the corner points mentioned in lines 3, 4 and 5 above were in conformance with the rules of the Michigan Board of Land Surveyors or by a Decree of a Court of Law; established, re-established, monumented, re-monumented, recovered, found as expressed below:

NOTE: Not more than 4 corners, all in the same town and range, may be recorded on this certificate.

A. Description of original monument and accessories and/or subsequent restoration:

J-7
 1855 Resurvey - Geo. H. Cannon (July) N29°W 29.68' 10" Elm
 Set Wood Post N66°E 53.20' 12" Ash
 13" Beech N57°W 12 links S18°E 64.53' 10" Lynn
 13" Beech S65°W 2 links Recorded on Page 252, Land
 1978 - Delmar E. Porter Recordation, September 29, 1978.
 Found 1/2" Rod set by Porter
 Set Monument Box


B. Description of corner evidence found and/or method applied in restoring or reestablishing corner:

J-7
 Found 1/2" Rod in Monument Box
 N68°E 53.52' 20" Ash
 S13°E 65.72' 16" Lynn
 N21°W 39.53' 12" Ash
 Set Cap #22428 on 1/2" Rod.

SURVEY &
REMONUMENTATION

1993

COMMISSION

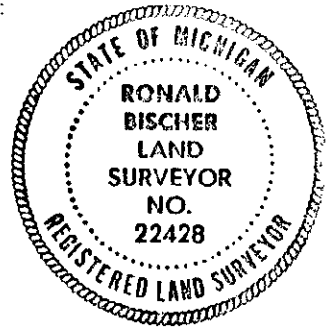

C. Description of monument for corner and accessories established to perpetuate locating the position of the corner:

J-7
 1/2" Rod and Cap #22428 in Monument Box
 N68°E 53.52' 20" Ash
 S13°E 65.72' 16" Lynn
 N21°W 39.53' 12" Ash
 N27°E 33.67' Fence corner

Ratified by Peer Group
in accordance with P.A. 345

Chairman Delmar E. Porter

Date December 7, 1993

*Witness tags and nails used.

Signed by Ronald R. Bischer

Date 12-13-93

Surveyor's Michigan License No. 22428