

1993

COMMISSION

LAND CORNER RECORDATION CERTIFICATE
Filing Requirement of Act 74, Mich. P.A. 1970

PRESQUE ISLE COUNTY
RECORDED

93 DEC 20 PM 4:46

Janet M. Lamb
REGISTER OF DEEDS

For corners in

Presque Isle
(County)

Located In: Corner Code #

1. Public Land Survey	T <u>34N</u> R <u>2E</u>	<u>K-12</u>
	T _____ R _____	_____
	T _____ R _____	_____
	T _____ R _____	_____
2. Property Controlling in Section	S _____ T _____ R _____	_____
	S _____ T _____ R _____	_____
3. Miscellaneous Property in Sec.	S _____ T _____ R _____	_____
	S _____ T _____ R _____	_____

LIBER **307** PAGE **824**

Register of Deeds Stamp & File Number

- 4. Lot No. _____, Recorded Plat _____
- 5. Private Claims _____

I, James A. Beck, in a field survey on September 22, 19 93, do hereby certify that under requirements of P.A. 74, Michigan P.A. of 1970, the corner points mentioned in lines 1 and 2 above were in conformance with regulations and rules therefore as required in the current manual of survey instructions of the United States Department of the Interior, Bureau of Land Management or by a decree of a Court of Law and/or that the corner points mentioned in lines 3, 4 and 5 above were in conformance with the rules of the Michigan Board of Land Surveyors or by a Decree of a Court of Law; established, re-established, monumented, re-monumented, recovered, found as expressed below:

NOTE: Not more than 4 corners, all in the same town and range, may be recorded on this certificate.

A	B	C	D	E	F	G	H	I	J	K	L	I
2	6	5	4	3	2	1						
3												
4	7	8	9	10	11	12						
5												
6	18	17	16	15	14	13						
7												
8	19	20	21	22	23	24						
9												
10	30	29	28	27	26	25						
11												
12	31	32	33	34	35	36						
13												


A. Description of original monument and accessories and/or subsequent restoration:

- K-12
1855: Original Monumentation by Geo H. Cannon in Government Resurvey of T34N-R2E. Set wood post at quarter section and referenced:
18" Beech S74°W 39 Links
15" Beech S55°E 13 Links
- 1987: Ronald R. Bischer, P.S. 22428, reset corner with 1/2" iron rod by single proportion. (Recorded Nov. 10, 1987, Presque Isle County Records) Referenced:
N08°E 82.20' Fence Corner
N17°W 53.04' 16" Cedar
S31°W 64.87' 8" Spruce
East 12.0' Fence

B. Description of corner evidence found and/or method applied in restoring or reestablishing corner:

- K-12
1993: Found 1/2" iron rod and cap 22428 (Ronald R. Bischer). Witnesses found (as recorded):
N17°W 53.04' 16" Cedar (old cut)

Ratified by Peer Group
in accordance with P.A. 345
Chairman *Delmer E. Porter*
Date November 29, 1993

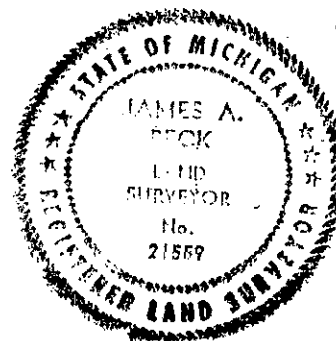

C. Description of monument for corner and accessories established to perpetuate locating the position of the corner:

- K-12
1993: 1/2" iron rod and cap L.S. 22428 guarded by a 3"x3"x3" cedar post. Corner falls on easterly side of recently timbered area, approximately 12' Westerly of N-S fence. Witnesses:
N17°W (r) 53.04' (m) 53.31' 17" Cedar (P.R., tag 21559)
S85°W 59.02' 6" Cedar (tag 21559)
N70°E 36.48' 3" Balsam (tag 21559)
S11°E 55.52' 8" Balsam (tag 21559)
P.R. = Previously Recorded

Signed by *James A. Beck*
Surveyor's Michigan License No. 21559

Date 12-14-1993

