

1993

PRESQUE ISLE COUNTY  
RECORDED

93 DEC 20 PM 1:47

COMMISSION

LAND CORNER RECORDATION CERTIFICATE

Filing Requirement of Act 74, Mich. P.A. 1970

For corners in

Presque Isle  
(County)

Located In:

Corner Code #

- 1. Public Land Survey      T 34N R 2E      L-1
- T    R
- T    R
- T    R
- 2. Property Controlling    S    T    R
- in Section                S    T    R
- 3. Miscellaneous            S    T    R
- Property in Sec.         S    T    R

*Janet M. Lamb*  
REGISTER OF DEEDS

LIBER 307 PAGE 828

Register of Deeds Stamp & File Number

- 4. Lot No. \_\_\_\_\_, Recorded Plat \_\_\_\_\_
- 5. Private Claims \_\_\_\_\_

A	B	C	D	E	F	G	H	I	J	K	L	M
2	6	5	4	3	2	1						
3												
4	7	8	9	10	11	12						
5												
6	18	17	16	15	14	13						
7												
8	19	20	21	22	23	24						
9												
10	30	29	28	27	26	25						
11												
12	31	32	33	34	35	36						
13												

I, James A. Beck, in a field survey on October 26, 19 93, do hereby certify that under requirements of P.A. 74, Michigan P.A. of 1970, the corner points mentioned in lines 1 and 2 above were in conformance with regulations and rules therefore as required in the current manual of survey instructions of the United States Department of the Interior, Bureau of Land Management or by a decree of a Court of Law and/or that the corner points mentioned in lines 3, 4 and 5 above were in conformance with the rules of the Michigan Board of Land Surveyors or by a Decree of a Court of Law; established, re-established, monumented, re-monumented, recovered, found as expressed below:

NOTE: Not more than 4 corners, all in the same town and range, may be recorded on this certificate.

A. Description of original monument and accessories and/or subsequent restoration:

L-1

1978: Delmer E. Porter, P.S. 15410, set concrete monument and brass cap in Presque Isle Remonumentation Project (Recorded Nov. 29, 1978, Presque Isle County Records).  
Referenced:  
N89°W 12.51' 9" Maple  
N66°E 26.31' 11" Beech  
S60°E 4.69' 14" Beech

B. Description of corner evidence found and/or method applied in restoring or reestablishing corner:

L-1

1993: Found concrete monument with brass cap as recorded by Delmer E. Porter. Found four witnesses as recorded by Norman J. Quaine, P.S. 33984 (Recorded Oct. 8, 1993, Liber 306, Page 976, Presque Isle County Records).  
Witnesses found (as recorded):  
S66°E 4.18' 13" Beech  
N67°E 26.38' 16" Beech  
S23°E 14.71' 16" Beech  
N88°W 12.44' 14" Maple  
Found new blazes and Porter tag 15410 in each tree.


Ratified by Peer Group  
in accordance with P.A. 345

Chairman Delmer E. Porter

C. Description of monument for Date and accessories established to perpetuate locating the position of the corner:

L-1

1993: Concrete monument with brass cap lies 9' Northerly of East-West fence and 37' Northerly of center of newly constructed driveway.  
Witnesses:  
S66°E (r) 4.18' (m) 4.12' 13" Beech (P.R.)  
N67°E (r) 26.38' (m) 26.31' 16" Beech (P.R.)  
N23°E (r) 14.71' (m) 14.72' 16" Beech  
N88°W (r) 12.44' (m) 12.43' 14" Maple (P.R.)  
P. R. = Previously Recorded  
All of above witnesses are blazed and set with Porter tag 15410.

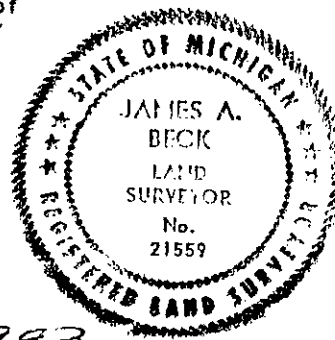

Signed by

*James A. Beck*

Date

12-14-1993

Surveyor's Michigan License No.

21559

## Corner History Research Sheet

N 1/4 Corner, Section 1, T34N-R2E, Presque Isle County  
(L-1)

Activity	Monument and Accessories	Comments
Oct., 1978: Renonumentation by Delmer E. Porter.	Set concrete monument with brass cap and referenced: N89°W 12.51' 9" Maple N66°E 26.31' 11" Beech S60°E 4.69' 14" Beech	Recorded Nov. 29, 1978, Presque Isle County Records.
Oct., 1993: Recorded by Norman J. Quaine.	Found Presque Isle concrete monument and brass cap. Referenced: S66°E 4.18' 13" Beech N67°E 26.38' 16" Beech S23°E 14.71' 16" Beech N88°W 12.44' 14" Maple	Recorded Oct. 8, 1993, Liber 306, Page 976, Presque Isle County Records.
Oct., 1993: Renonumentation by James A. Beck.	Found concrete monument with brass cap. Corner is 9' Northerly of East-West fence and 37' Northerly of center of newly constructed driveway. Found four recorded witnesses. Referenced: P. R.: S66°E (r) 4.18' (m) 4.12' 13" Beech P. R.: N67°E (r) 26.38' (m) 26.31' 16" Beech P. R.: N23°E (r) 14.71' (m) 14.72' 16" Beech P. R.: N88°W (r) 12.44' (m) 12.43' 14" Maple	All of above witnesses were found newly blazed and set with Porter tag 15410.

P. R. = Previously Recorded

December 2, 1993

James A. Beck, P. S. 21559