

93 DEC 20 PM 4:47

LAND CORNER RECORDATION CERTIFICATE
Filing Requirement of Act 74, Mich. P.A. 1970

For corners in
Presque Isle

Gene M. Lamb
REGISTER OF DEEDS

	Located In:	Corner Code #
1. Public Land Survey	T <u>34N</u> R <u>2E</u>	<u>L-7</u>
	T _____ R _____	_____
	T _____ R _____	_____
	T _____ R _____	_____
2. Property Controlling in Section	S _____ T _____ R _____	_____
	S _____ T _____ R _____	_____
3. Miscellaneous Property in Sec.	S _____ T _____ R _____	_____
	S _____ T _____ R _____	_____

LIBER 307 PAGE 834

Register of Deeds Stamp & File Number

4. Lot No. _____, Recorded Plat _____
 5. Private Claims _____

	A	B	C	D	E	F	G	H	I	J	K	L	M
2	6	5	4	3	2	1							
3													
4	7	8	9	10	11	12							
5													
6	18	17	16	15	14	13							
7													
8	19	20	21	22	23	24							
9													
10	30	29	28	27	26	25							
11													
12	31	32	33	34	35	36							
13													

I, James A. Beck, in a field survey on October 27, 1993, do hereby certify that under requirements of P.A. 74, Michigan P.A. of 1970, the corner points mentioned in lines 1 and 2 above were in conformance with regulations and rules therefore as required in the current manual of survey instructions of the United States Department of the Interior, Bureau of Land Management or by a decree of a Court of Law and/or that the corner points mentioned in lines 3, 4 and 5 above were in conformance with the rules of the Michigan Board of Land Surveyors or by a Decree of a Court of Law; established, re-established, monumented, re-monumented, recovered, found as expressed below:

NOTE: Not more than 4 corners, all in the same town and range, may be recorded on this certificate.

A. Description of original monument and accessories and/or subsequent restoration:

- 1855: Original monumentation by Geo. H. Cannon in Government Resurvey of T34N-R2E. Set wood post at quarter section and referenced:
 8" Cedar N50°W 35 Links
 5" Cedar S20°E 23 Links
- 1976: Ronald R. Bischer, P.S. 22428, set 1/2" iron rod and cap by single proportion. (Recorded March 30, 1976, Presque Isle County Records) Referenced:
 N15°W 29.34' 14" Cedar
 N80°W 11.71' 6" Cedar
 N25°E 28.24' 9" Cedar

B. Description of corner evidence found and/or method applied in restoring or reestablishing corner:


- L-7
 1993: Found iron and decayed cap set by Delmer E. Porter (P.S. 15410). Found two witnesses as recorded by Ronald R. Bischer in 1976. Witnesses found (as recorded):
 N15°W 29.34' 14" Cedar (found blazed tree blown down)
 N80°W 11.71' 6" Cedar (found blazed tree blown down)

Ratified by Peer Group
 in accordance with P.A. 345
 Chairman *Delmer E. Porter*
 Date November 29, 1993

SURVEY &
 RECONSTRUCTION
 1993
 COMMISSION

C. Description of monument for corner and accessories established to perpetuate locating the position of the corner:

- L-7
 1993: 1/2" iron rod and cap P.S. 21559 in cut-over area amidst wind-fallen trees. Corner falls on woodline to South and approximately 80 feet Sly of East-West woodline. Fence remnants are approximately 2 feet East of corner. Witnesses:
 North 11.75' 7" Cedar (tag 21559)
 S26°W 50.51' 6" Cedar (tag 21559)
 S12°E 10.34' 6" Cedar (tag 21559)
 N10°W 1.61' 8' -high Cedar Post (tag 21559)

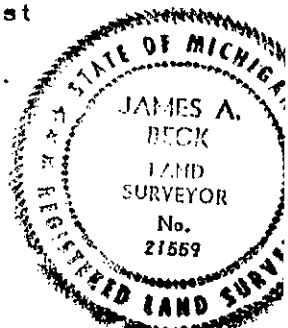

Signed by *James A. Beck* Date 12-14-1993
 Surveyor's Michigan License No. 21559

Corner History Research Sheet

S 1/4 Corner, Section 13, T34N-R2E, Presque Isle County
(L-7)

Activity	Monument and Accessories	Comments
1855: Government Resurvey by Geo H. Cannon.	Set wood post at quarter section and referenced: 8" Cedar N50°W 35 Links 5" Cedar S20°E 23 Links	
February, 1976: Recorded by Ronald R. Bischer.	Set 1/2" rod and cap #22428 by single proportion. Referenced: N15°W 29.34' 14" Cedar N80°W 11.71' 6" Cedar N25°E 28.24' 9" Cedar	Recorded March 30, 1976, Presque Isle County Records.
October, 1993: Remonumentation by James A. Beck.	Found iron and deteriorated cap set by Delmer E. Porter (P.S. 15410) in a cut-over area amidst wind-fallen trees. Corner falls on woodline to South and approximately 80 feet Sly of East-West woodline. Fence remnants are approximately 2' East of corner. Found two blown-over bearing trees that appear to have fit the corner. Set cap P.S. 21559 and established four new witnesses. Referenced:	
P. R. : N15°W (r) 29.34' (m) approx. 29' 14" Cedar (blown down, old blaze)		
P. R. : N80°W (r) 11.71' (m) approx. 12' 9" Cedar (blown down, old blaze)		
new: North 11.75' 7" Cedar (set tag 21559)		
new: S26°W 50.51' 6" Cedar (set tag 21559)		
new: S12°E 10.34' 6" Cedar (set tag 21559)		
new: N10°W 1.61' 8' high Cedar Post (set tag 21559)		

P. R. = Previously Recorded

December 2, 1993

James A. Beck, P.S. 21559