

1993

COMMISSION

LAND CORNER RECORDATION CERTIFICATE
Filing Requirement of Act 74, Mich. P.A. 1970

PRESQUE ISLE COUNTY
RECORDED

93 DEC 20 PM 4:47

Janet M. Lamb
REGISTER OF DEEDS

For corners in

Presque Isle (County)	Located In:	Corner Code #
1. Public Land Survey	T 34N R 2E	M-1
	T ___ R ___	_____
	T ___ R ___	_____
	T ___ R ___	_____
2. Property Controlling in Section	S ___ T ___ R ___	_____
	S ___ T ___ R ___	_____
3. Miscellaneous Property in Sec.	S ___ T ___ R ___	_____
	S ___ T ___ R ___	_____

LIBER 307 PAGE 842

Register of Deeds Stamp & File Number

4. Lot No. _____, Recorded Plat _____
5. Private Claims _____

A	B	C	D	E	F	G	H	I	J	K	L	M
2	6	5	4	3	2	1						
3												
4	7	8	9	10	11	12						
5												
6	18	17	16	15	14	13						
7												
8	19	20	21	22	23	24						
9												
10	30	29	28	27	26	25						
11												
12	31	32	33	34	35	36						
13												

I, James A. Beck, in a field survey on October 25, 19 93, do hereby certify that under requirements of P.A. 74, Michigan P.A. of 1970, the corner points mentioned in lines 1 and 2 above were in conformance with regulations and rules therefor as required in the current manual of survey instructions of the United States Department of the Interior, Bureau of Land Management or by a decree of a Court of Law and/or that the corner points mentioned in lines 3, 4 and 5 above were in conformance with the rules of the Michigan Board of Land Surveyors or by a Decree of a Court of Law; established, re-established, monumented, re-monumented, recovered, found as expressed below:


NOTE: Not more than 4 corners, all in the same town and range, may be recorded on this certificate.

A. Description of original monument and accessories and/or subsequent restoration:

- M-1
1855: Original monumentation by Geo H. Cannon in Government Resurvey of T34N-R2E. Intersected South boundary of T35N-R2E and set post. Referenced:
8" Cedar S70°W 22 Links
10" Tamarock S65°E 37 Links
- 1978: Delmer E. Porter, P.S. 15410, found old stake point and O.B.T. stumps. Set concrete monument and brass cap in Presque Isle Remonumentation Project (Recorded Nov. 29, 1978, Presque Isle County Records). Referenced:
Due N 14.13' 5" Cedar
S15°E 20.40' 9" Cedar
S52°W 13.02' 6" Cedar

B. Description of corner evidence found and/or method applied in restoring or reestablishing corner:

- M-1
1993: Found concrete monument with brass cap guarded by 4" x 4" cedar stake and three witnesses recorded by Delmer E. Porter in his remonumentation of the corner.
Witnesses found (as recorded):
Due N 14.13' 5" Cedar (found old blaze and overgrown tag)
S15°E 20.40' 9" Cedar { " }
S52°W 13.02' 6" Cedar { " }

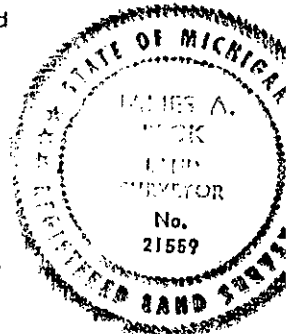

Ratified by Peer Group
in accordance with P.A. 345
Chairman Delmer E. Porter
Date November 29, 1993

C. Description of monument for corner and accessories established to perpetuate locating the position of the corner:

- M-1
1993: Concrete monument with brass cap guarded by 4" x 4" cedar stake.
Witnesses:
Due N 14.13' 6" Cedar (P.R., set tag 21559)
S15°E (r) 20.40' (m) 20.50' 10" Cedar (P.R., set tag 21559)
S52°W 13.02' 7" Cedar (P.R., set tag 21559)
N40°W 28.40' 7" Cedar (set tag 21559)
P. R. = Previously Recorded

Signed by James A. Beck Date 12-14-1993
Surveyor's Michigan License No. 21559

Corner History Research Sheet

LIBER 307 PAGE 843

NE Corner, Section 1, T34N-R2E, Presque Isle County
(M-1)

Activity	Monument and Accessories	Comments
1855: Government Resurvey by Geo H. Cannon.	Intersected South boundary of T35NR2E and set post. Referenced: 8" Cedar S70°W 22 Links 10" Tamarack S65°E 37 Links	
Oct., 1978: Remonumentation by Delmer E. Porter.	Found old stake point and O.B.T. stumps. Set concrete monument with brass cap and referenced: Due N 14.13' 5" Cedar S15°E 20.40' 9" Cedar S52°W 13.02' 6" Cedar	Recorded Nov. 29, 1978, Presque Isle County Records.
Oct., 1993: Remonumentation by James A. Beck.	Found concrete monument with brass cap guarded by 4" x 4" cedar stake. Found three recorded witnesses and established one additional witness. Referenced: P.R.: Due N 14.13' 6" Cedar (old blaze, old tag overgrown, set tag 21559) P.R.: S15°E (r)20.40' (m)20.50' 10" Cedar (") P.R.: S52°W 13.02' 7" Cedar (") New: N40°W 28.40' 7" Cedar (set tag 21559)	

P.R. = Previously Recorded

December 2, 1993

James A. Beck, P.S. 21559

SURVEY &
MONUMENTATION

JAN 22 2001

SECTION