

1993

COMMISSION

LAND CORNER RECORDATION CERTIFICATE
Filing Requirement of Act 74, Mich. P.A. 1970

PRESQUE ISLE COUNTY
RECORDED

93 DEC 20 PM 4:47

James M. Lamb
REGISTER OF DEEDS

For corners in
Presque Isle
(County)

Located in: Corner Code #
T 34N R 2E M-2
T R
T R
T R
S T R
S T R
S T R
S T R

LIBER 307 PAGE 844

Register of Deeds Stamp & File Number

4. Lot No. , Recorded Plat
5. Private Claims


Grid table with columns A-L and rows 1-13 containing numbers 1-36.

I, James A. Beck, in a field survey on October 25, 1993, do hereby certify that under requirements of P.A. 74, Michigan P.A. of 1970, the corner points mentioned in lines 1 and 2 above were in conformance with regulations and rules therefore as required in the current manual of survey instructions of the United States Department of the Interior, Bureau of Land Management or by a decree of a Court of Law and/or that the corner points mentioned in lines 3, 4 and 5 above were in conformance with the rules of the Michigan Board of Land Surveyors or by a Decree of a Court of Law; established, re-established, monumented, re-monumented, recovered, found as expressed below:

NOTE: Not more than 4 corners, all in the same town and range, may be recorded on this certificate.

A. Description of original monument and accessories and/or subsequent restoration:

M-2 1855: Original monumentation by Geo H. Cannon in Government Resurvey of T34N-R2E. Set wood post at quarter section and referenced: 8" Tamarack S73'E 42 Links 5" Spruce S68'W 7 Links
1978: Delmer E. Porter, P. S. 15410, found old stake top and point and probable locations of O.B.T. stumps. Set concrete monument and brass cap in Presque Isle Remonumentation Project (Recorded Nov. 29, 1978, Presque Isle County Records.) Referenced: N32'E 41.17' 9" Cedar N33'W 32.30' 5" Cedar S67'W 28.88' 8" Cedar

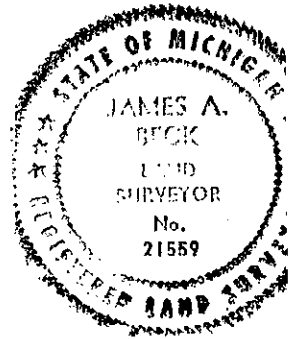

B. Description of corner evidence found and/or method applied in restoring or reestablishing corner:

M-2 1993: Found concrete monument with brass cap guarded by a 3" x 3" cedar stake and three witnesses recorded by Delmer E. Porter in his remonumentation of the corner. Witnesses found (as recorded): N32'E 41.17' 9" Cedar (found old blaze and grown over tag) N33'W 32.30' 5" Cedar (") S67'W 28.88' 8" Cedar (")

Ratified by Peer Group in accordance with P.A. 345
Chairman Delmer E. Porter
Date November 29, 1993

C. Description of monument for corner and accessories established to perpetuate locating the position of the corner:

M-2 1993: Concrete monument with brass cap guarded by a 3" x 3" cedar stake. Witnesses: N32'E 41.17' 10" Cedar (P. R., set tag 21559) N33'W (r) 32.30' (m) 32.33' 6" Cedar (P. R., set tag 21559) S67'W (r) 28.88' (m) 28.69' 9" Cedar (P. R., set tag 21559) S74'E 38.79' 4" Cedar (set tag 21559) S04'W 22.18' 5" Twin Cedar (set tag 21559 in W-most twin)

P. R. = Previously Recorded

Signed by James A. Beck
Surveyor's Michigan License No. 21559

Date 12-14-1993

Corner History Research Sheet

E 1/4 Corner, Section 1, T34N-R2E, Presque Isle County
(M-2)

LIBER 307 PAGE 845

Activity	Monument and Accessories	Comments
1855: Government Resurvey by Geo H. Cannon.	Set wood post at quarter section and referenced: 8" Tamarack S73°E 42 Links 5" Spruce S68°W 7 Links	Recorded Nov. 29, 1978, Presque Isle County Records.
Oct., 1978: Remonumentation by Delmer E. Porter.	Found old stake top and point and probable locations of O. B. T. stumps. Set concrete monument with brass cap and referenced: N32°E 41.17' 9" Cedar N33°W 32.30' 5" Cedar S67°W 28.88' 8" Cedar	Recorded Nov. 29, 1978, Presque Isle County Records.
Oct., 1993: Remonumentation by James A. Beck.	Found a concrete monument with brass cap guarded by a 3"x3" cedar stake. Found three recorded witnesses and established two additional witnesses. Referenced: P. R. : N32°E 41.17' 10" Cedar (old blaze, grown-over tag, set tag P. S. 21559) P. R. : N33°W (r)32.30' (m)32.33' 6" Cedar (") P. R. : S67°W (r)28.88' (m)28.69' 9" Cedar (") New: S74°E 38.79' 4" Cedar (set tag P. S. 21559) New: S04°W 22.18' 5" Twin Cedar (set tag P. S. 21559 in W-most twin)	

P. R. = Previously Recorded

December 2, 1993

James A. Beck, P. S. 21559