

1069

LAND CORNER RECORDATION CERTIFICATE
Filing Requirement of Act 74, Mich. P.A. 1970

LIBER 318 PAGE 738

For corners in
Presque Isle
(County)

Located In:

Corner Code #

- 1. Public Land Survey T 34N R 5E C-5
 T R _____
 T R _____
 T R _____
- 2. Property Controlling S T R _____
 in Section S T R _____
 S T R _____
- 3. Miscellaneous S T R _____
 Property in Section S T R _____
- 4. Lot No. _____, Recorded Plat _____
- 5. Private Claims _____

PRESQUE ISLE COUNTY
RECORDED
96 JUN 13 PM 12: 26
Janet M. Lambert
REGISTER OF DEEDS
Register of Deeds Stamp & File Number

I, Ronald Bischer, in a field survey on 3-21, 19 96, do hereby certify that under requirements of P.A. 74, Michigan P.A. of 1970, the corner points mentioned in lines 1 and 2 above were in conformance with regulations and rules therefore as required in the current manual of survey instructions of the United States Department of the Interior, Bureau of Land Management or by a decree of a Court of Law and/or that the corner points mentioned in lines 3, 4 and 5 above were in conformance with the rules of the Michigan Board of Professional Surveyors or by a Decree of a Court of Law; established, re-established, monumented, re-monumented, recovered, found as expressed below:

A	B	C	D	E	F	G	H	I	J	K	L	M
2	6	5	4	3	2	1						
3												
4	7	8	9	10	11	12						
5												
6	18	17	16	15	14	13						
7												
8	19	20	21	22	23	24						
9												
10	30	29	28	27	26	25						
11												
12	31	32	33	34	35	36						
13												


NOTE: Not more than 4 corners, all in the same town and range, may be recorded on this certificate.

A. Description of original monument and accessories and/or subsequent restoration:

- C-5
1856 Alfred Millend Set Wood Post
N43°W 18 links 10 Sugar
S50°E 34 links 10" Sugar
4-14-78 Delmar Porter found 1" pipe, set mon box, left 3 witnesses
9-25-78 Delmar Porter found 1" pipe, raised with 1/2" rod & cap in Mon. box
4-10-89 Ronald Bischer found 1/2" rod in Mon. box, left 3 witnesses.
4-3-92 Ronald Bischer found 1" pipe in mon. box. left 3 witnesses.
6-14-94 Ronald Bischer found 1" pipe in mon. box. left 3 witnesses.
4-11-95 James Beck found 1/2" iron in Mon. box. Left 5 witnesses

B. Description of corner evidence found and/or method applied in restoring or reestablishing corner:

- C-5
3-21-96 Ronald Bischer found 1/2" Rod & Cap #15410 in Mon. box
N43°W 47.7' 18" Maple
S48°W 52.18' P. pole
S73°W 75.92' Stop sign
N49°W 56.07' Underground cable marker

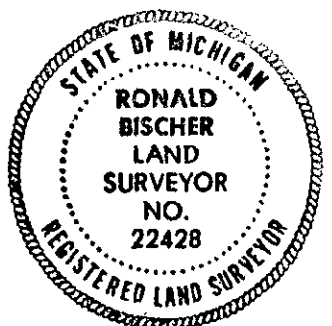

C. Description of monument for corner and accessories established to perpetuate locating the position of the corner:

- C-5
3-21-96 Ronald Bischer
1/2" Rod & Cap #15410 in Mon. Box
N46°E 47.48' 20" Box Elder
N46°W 56.00' Gas line marker
S50°W 52.10' P. pole
S75°W 75.81' Stop sign

Ratified by Peer Group
in accordance with P.A. 345
Chairman *Delmar Porter*
Date 6/12/96

Signed by Ronald R. Bischer

Date 6-6-96

Surveyor's Michigan License No. 22428