1064

LIBER 318 PAGE 733

LAND CORNER RECORDATION CERTIFICATE

Filing Requirement of Act 74, Mich. P.A. 1970

For corners in Presque Isle (County)

	Located In:	Corner Code #
1. Public Land Survey	T 34N R 5E	C-6
	T ___ R ___	
	T ___ R ___	
	T ___ R ___	
2. Property Controlling	S ___ T ___ R ___	
in Section	S ___ T ___ R ___	
3. Miscellaneous	S ___ T ___ R ___	
Property in Section	S ___ T ___ R ___	

PRESQUE ISLE COUNTY
RECORDED
96 JUN 13 PM 12: 25
Janice M. Lamb
REGISTER OF DEEDS

Register of Deeds Stamp & File Number

4. Lot No. _____, Recorded Plat _____
5. Private Claims _____

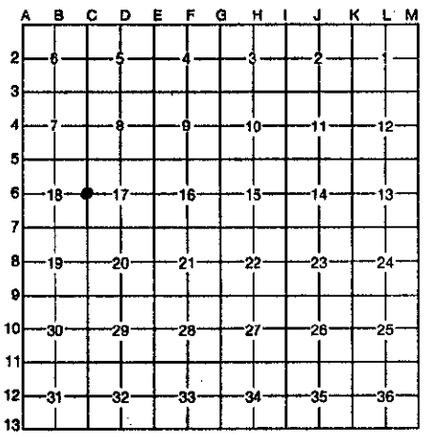

I, Ronald Bischer, in a field survey on 3-21, 19 96, do hereby certify that under requirements of P.A. 74, Michigan P.A. of 1970, the corner points mentioned in lines 1 and 2 above were in conformance with regulations and rules therefore as required in the current manual of survey instructions of the United States Department of the Interior, Bureau of Land Management or by a decree of a Court of Law and/or that the corner points mentioned in lines 3, 4 and 5 above were in conformance with the rules of the Michigan Board of Professional Surveyors or by a Decree of a Court of Law; established, re-established, monumented, re-monumented, recovered, found as expressed below:

NOTE: Not more than 4 corners, all in the same town and range, may be recorded on this certificate.

A. Description of original monument and accessories and/or subsequent restoration:

C-6
1856 Alfred Millend Set Wood Post
N70°W 15 links 11" Sugar
S80°E 27 links 15" Sugar

4-10-89 Ronald Bischer Set 1/2" Rod by single proportion left 3 witnesses

B. Description of corner evidence found and/or method applied in restoring or reestablishing corner:

C-6
3-21-96 Ronald Bischer found 1/2" rod and cap #22428
West 38.90' P. pole
N79°E 73.55' 6" Lynn
S86°E 64.10' 4" Ash

STATE OF MICHIGAN
RONALD BISCHER LAND SURVEYOR NO. 22428
REGISTERED LAND SURVEYOR

C. Description of monument for corner and accessories established to perpetuate locating the position of the corner:

C-6
3-21-96 Ronald Bischer
1/2" Rod & Cap # 22428
West 40.10' P. pole (new pole)
N79°E 73.55' 9" lynn
S86°E 64.10' 5" Ash
N70°E 80.35' 4" Apple

Ratified by Group in accordance with P.A. 345
Chairman [illegible]
Date 6/12/96

Signed by Ronald R. Bischer Date 6-6-96

Surveyor's Michigan License No. 22428

FORM APPROVED BY MICHIGAN STATE BOARD OF PROFESSIONAL SURVEYORS, JAN. 28, 1971
REVISED MAY 14, 1975
REVISED JAN., 1983