

1066

LAND CORNER RECORDATION CERTIFICATE
Filing Requirement of Act 74, Mich. P.A. 1970

For corners in Presque Isle (County) Located In: Corner Code #
1. Public Land Survey T 34N R 5E C-8
2. Property Controlling in Section S T R
3. Miscellaneous Property in Section S T R

PRESQUE ISLE COUNTY RECORDED

96 JUN 13 PM 12:25

Janet M. Lamb REGISTER OF DEEDS

Register of Deeds Stamp & File Number

4. Lot No. , Recorded Plat
5. Private Claims

Grid table with columns A-M and rows 2-13. A dot is marked at row 8, column C.

I, Ronald Bischer, in a field survey on 3-21, 1996, do hereby certify that under requirements of P.A. 74, Michigan P.A. of 1970, the corner points mentioned in lines 1 and 2 above were in conformance with regulations and rules therefore as required in the current manual of survey instructions of the United States Department of the Interior, Bureau of Land Management or by a decree of a Court of Law and/or that the corner points mentioned in lines 3, 4 and 5 above were in conformance with the rules of the Michigan Board of Professional Surveyors or by a Decree of a Court of Law; established, re-established, monumented, re-monumented, recovered, found as expressed below:


NOTE: Not more than 4 corners, all in the same town and range, may be recorded on this certificate.

A. Description of original monument and accessories and/or subsequent restoration:

C-8
1856 Alfred Millend Set Wood Post
S20°E 20 links 12" Cedar
N40°W 27 links 6" Cedar
12-6-84 Delmar Porter Set 1/2" Rod @ Int. 1/4 line & Sec. line fences left 4 witnesses
1-13-92 Thomas Fabis 1/2" Iron rod and cap #15410 left 3 witnesses

B. Description of corner evidence found and/or method applied in restoring or reestablishing corner:

C-8
3-21-96 Ronald Bischer found 1/2" rod set cap #22428
S44°E 25.42' 8" Cedar
S78°W 36.57' 12" Cedar
West 10' 2' Wide creek

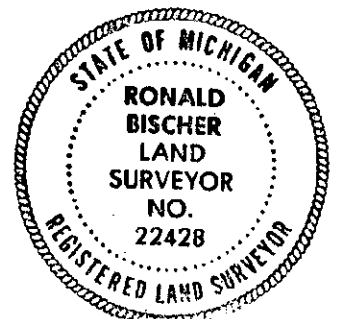

C. Description of monument for corner and accessories established to perpetuate locating the position of the corner:

C-8
3-21-96 Ronald Bischer
1/2" Rod & Cap #22428
S44°E 25.42' 8" Cedar
S72°W 36.57' 12" Cedar
N14°W 53.16' 18" Cedar
N44°E 45.45' 5" Twin Maple
West 10' 2' Wide creek

Ratified by Peer Group in accordance with P.A. 345
Chairman [Signature]
Date 6/12/96

Signed by Ronald R. Bischer

Date 6-6-96

Surveyor's Michigan License No. 22428