

LAND CORNER RECORDATION CERTIFICATE
Filing Requirement of Act 74, Mich. P.A. 1970

For corners in Presque Isle (County) Located In: Corner Code #

1. Public Land Survey	T	<u>34N</u>	R	<u>5E</u>	<u>C-10</u>	
	T	_____	R	_____	_____	
	T	_____	R	_____	_____	
	T	_____	R	_____	_____	
2. Property Controlling in Section	S	_____	T	_____	R	_____
	S	_____	T	_____	R	_____
3. Miscellaneous Property in Section	S	_____	T	_____	R	_____
	S	_____	T	_____	R	_____

PRESQUE ISLE COUNTY
 RECORDED
 96 JUN 13 PM 12: 25
Janet M. Lamb
 Register of Deeds Stamp & File Number
 REGISTER OF DEEDS

4. Lot No. _____, Recorded Plat _____
 5. Private Claims _____

I, Ronald Bischer, in a field survey on 3-15, 19 96, do hereby certify that under requirements of P.A. 74, Michigan P.A. of 1970, the corner points mentioned in lines 1 and 2 above were in conformance with regulations and rules therefore as required in the current manual of survey instructions of the United States Department of the Interior, Bureau of Land Management or by a decree of a Court of Law and/or that the corner points mentioned in lines 3, 4 and 5 above were in conformance with the rules of the Michigan Board of Professional Surveyors or by a Decree of a Court of Law; established, re-established, monumented, re-monumented, recovered, found as expressed below:

NOTE: Not more than 4 corners, all in the same town and range, may be recorded on this certificate.


	A	B	C	D	E	F	G	H	I	J	K	L	M
2	6		5		4		3		2		1		
3													
4	7		8		9		10		11		12		
5													
6	18		17		16		15		14		13		
7													
8	19		20		21		22		23		24		
9													
10	30		29		28		27		26		25		
11													
12	31		32		33		34		35		36		
13													

A. Description of original monument and accessories and/or subsequent restoration:

C-10
 1856 Alfred Millend
 Set Wood Post
 N60°E 2 links 18" Beech
 S62°W 20 links 5" Sugar Maple

B. Description of corner evidence found and/or method applied in restoring or reestablishing corner:

C-10
 3-15-96 Ronald Bischer set 1/2" rod & cap #22428 at old fence corner.

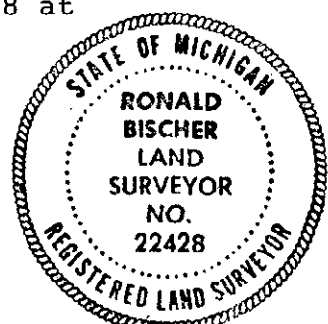

C. Description of monument for corner and accessories established to perpetuate locating the position of the corner:

C-10
 3-15-96 Ronald Bischer
 1/2" rod & cap #22428
 N82°E 11.08' 24" Maple
 N86°W 21.35' 15" Ash
 S05°E 38.17' 18" Maple
 S60°W 45.88' 18" Maple

Ratified by Peer Group
 in accordance with P.A. 345
 Chairman *James E. Lohr*
 Date 6/12/96

Signed by Ronald R. Bischer
 Surveyor's Michigan License No. 22428

Date 6-6-96