

1001

LAND CORNER RECORDATION CERTIFICATE
Filing Requirement of Act 74, Mich. P.A. 1970

LIBER 318 PAGE 730

For corners in
Presque Isle
(County)

Located in:

Corner Code #

1. Public Land Survey	T	<u>34N</u>	R	<u>5E</u>	<u>C-13</u>	
	T	_____	R	_____	_____	
	T	_____	R	_____	_____	
	T	_____	R	_____	_____	
2. Property Controlling in Section	S	_____	T	_____	R	_____
	S	_____	T	_____	R	_____
3. Miscellaneous Property in Section	S	_____	T	_____	R	_____
	S	_____	T	_____	R	_____

PRESQUE ISLE COUNTY
RECORDED

96 JUN 13 PM 12:24

Jane M. Lamb
REGISTER OF DEEDS
Register of Deeds Stamp & File Number

4. Lot No. _____, Recorded Plat _____
5. Private Claims _____

	A	B	C	D	E	F	G	H	I	J	K	L	M
2	6		5		4		3		2		1		
3													
4	7		8		9		10		11		12		
5													
6	18		17		16		15		14		13		
7													
8	19		20		21		22		23		24		
9													
10	30		29		28		27		26		25		
11													
12	31		32		33		34		35		36		
13													

I, Ronald Bischer, in a field survey on 3-13, 1996, do hereby certify that under requirements of P.A. 74, Michigan P.A. of 1970, the corner points mentioned in lines 1 and 2 above were in conformance with regulations and rules therefore as required in the current manual of survey instructions of the United States Department of the Interior, Bureau of Land Management or by a decree of a Court of Law and/or that the corner points mentioned in lines 3, 4 and 5 above were in conformance with the rules of the Michigan Board of Professional Surveyors or by a Decree of a Court of Law; established, re-established, monumented, re-monumented, recovered, found as expressed below:


NOTE: Not more than 4 corners, all in the same town and range, may be recorded on this certificate.

A. Description of original monument and accessories and/or subsequent restoration:

C-13
1840 John Hodgson set wood post
N59°W 21 lks 14" Hemlock
N58°E 44 lks 14" Bl. Ash
8-28-79 Delmar Porter found 1/2" rod
left 3 witnesses
10-23 89 Ron Bischer found 1/2" rod
left 5 witnesses
3-23-94 Norman Quaine set 1/2" rod using previous information
left 4 witnesses

B. Description of corner evidence found and/or method applied in restoring or reestablishing corner:

C-13
3-13-96 Ron Bischer found 1/2" rod & cap #33984
found old witnesses
S55°E 63.50' 8" Maple
S09°E 47.19' 6" Balsam
S66°W 67.75' 6" Cedar
N31°E 53.09' 4" Spruce

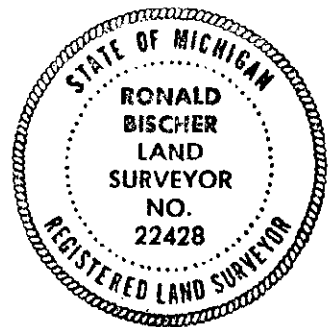

C. Description of monument for corner and accessories established to perpetuate locating the position of the corner:

C-13
3-13-96 Ron Bischer found 1/2" rod&cap # 33984
S59°E 63.47' 8" Maple
S09°E 47.19' 6" Balsam
S61°W 67.49' 6" Cedar
N31°E 53.09' 4" Spruce
S25°W 79.43' 20" White Pine

Ratified by Peer Group
in accordance with P.A. 345
Chairman *Delmar Porter*
Date 6/12/96

Signed by Ronald R. Bischer

Date 6-6-96

Surveyor's Michigan License No. 22428