

**LAND CORNER RECORDATION CERTIFICATE**  
**Filing Requirement of Act 74, Mich. P.A. 1970**

LIBER **318** PAGE **726**

For corners in

Presque Isle  
(County)

Located In:

Corner Code #

- |                                      |   |            |   |           |            |       |
|--------------------------------------|---|------------|---|-----------|------------|-------|
| 1. Public Land Survey                | T | <u>34N</u> | R | <u>5E</u> | <u>D-7</u> |       |
|                                      | T | _____      | R | _____     | _____      |       |
|                                      | T | _____      | R | _____     | _____      |       |
|                                      | T | _____      | R | _____     | _____      |       |
| 2. Property Controlling in Section   | S | _____      | T | _____     | R          | _____ |
|                                      | S | _____      | T | _____     | R          | _____ |
| 3. Miscellaneous Property in Section | S | _____      | T | _____     | R          | _____ |
|                                      | S | _____      | T | _____     | R          | _____ |

PRESQUE ISLE COUNTY  
 RECORDED

96 JUN 13 PM 12:23

*Janet M. Slamb*  
 REGISTER OF DEEDS

Register of Deeds Stamp & File Number

4. Lot No. \_\_\_\_\_, Recorded Plat \_\_\_\_\_  
 5. Private Claims \_\_\_\_\_

I, Ronald Bischer, in a field survey on 3-12, 1996, do hereby certify that under requirements of P.A. 74, Michigan P.A. of 1970, the corner points mentioned in lines 1 and 2 above were in conformance with regulations and rules therefore as required in the current manual of survey instructions of the United States Department of the Interior, Bureau of Land Management or by a decree of a Court of Law and/or that the corner points mentioned in lines 3, 4 and 5 above were in conformance with the rules of the Michigan Board of Professional Surveyors or by a Decree of a Court of Law; established, re-established, monumented, re-monumented, recovered, found as expressed below:

**NOTE: Not more than 4 corners, all in the same town and range, may be recorded on this certificate.**

	A	B	C	D	E	F	G	H	I	J	K	L	M
2	6	5	4	3	2								
3													
4	7	8	9	10	11	12							
5													
6	18	17	16	15	14	13							
7													
8	19	20	21	22	23	24							
9													
10	30	29	28	27	26	25							
11													
12	31	32	33	34	35	36							
13													


**A. Description of original monument and accessories and/or subsequent restoration:**

- D-7  
 1856 Alfred Millend Set Wood Post  
 N75°E 10 links 4" Beech  
 S86°W 10 links 5" Sugar  
 7-13-77 Ronald Bischer found 1" iron with 3 witnesses  
 7-13-77 Delmar Porter found 1" iron with 3 witnesses  
 10-16-79 Delmar Porter replaced 1" rod with Presque Isle County Remonumentation Monument. left 3 witnesses  
 4-27-84 Delmar Porter found P.I. County Mon. left 3 witnesses  
 1-13-92 Thomas Fabis Set P.K. Nail in pavement left 3 witnesses

**B. Description of corner evidence found and/or method applied in restoring or reestablishing corner:**

- 1-7-92 Thomas Fabis Set P.K. Nail from witnesses. left 4 witnesses  
 7-28-95 Norman Quaine Fd. P.K. Nail & witnesses. set 1/2" rod & cap in Mon box. left 4 witnesses

- D-7  
 3-12-96 Ronald Bischer Found 1/2" rod & cap #33984 in  
 S59°E 90.87' P. Pole  
 N77°E 90.96' P. Pole  
 N01°W 50.22' 4" Balsam  
 N39°W 70.38' 5" Cedar

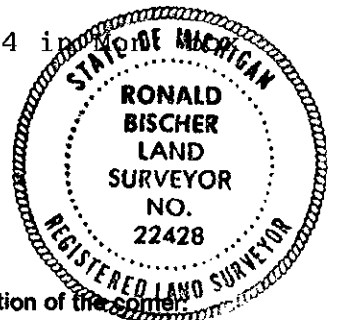

**C. Description of monument for corner and accessories established to perpetuate locating the position of the corner:**

- D-7  
 3-12-96 Ronald Bischer  
 1/2" Rod & Cap #33984 in Mon. Box.  
 S59°E 90.87' Power pole  
 N77°E 90.96' Power pole  
 N11°W 50.22' 4" Balsam  
 N39°W 70.18' 3" Cedar  
 N57°E 52.71' 8" Norway pine

Ratified by Peer Group  
 in accordance with P.A. 345

Chairman *Delmar Porter*

Date 6/12/96

Signed by Ronald E. Bischer

Date 6-6-96

Surveyor's Michigan License No. 22428