

1053

LAND CORNER RECORDATION CERTIFICATE
Filing Requirement of Act 74, Mich. P.A. 1970

For corners in
Presque Isle
(County)

Located In:

Corner Code #

PRESQUE ISLE COUNTY
RECORDED

96 JUN 13 PM 12:23

Janet M. Samb
REGISTER OF DEEDS

Register of Deeds Stamp & File Number

- | | | | | | |
|--------------------------------------|---|------------|---|-----------|------------|
| 1. Public Land Survey | T | <u>34N</u> | R | <u>5E</u> | <u>E-5</u> |
| | T | _____ | R | _____ | _____ |
| | T | _____ | R | _____ | _____ |
| | T | _____ | R | _____ | _____ |
| 2. Property Controlling in Section | S | _____ | T | _____ | R |
| | S | _____ | T | _____ | R |
| 3. Miscellaneous Property in Section | S | _____ | T | _____ | R |
| | S | _____ | T | _____ | R |

4. Lot No. _____, Recorded Plat _____
5. Private Claims _____

	A	B	C	D	E	F	G	H	I	J	K	L	M
2	6	5	4	3	2	1							
3													
4	7	8	9	10	11	12							
5													
6	18	17	16	15	14	13							
7													
8	19	20	21	22	23	24							
9													
10	30	29	28	27	26	25							
11													
12	31	32	33	34	35	36							
13													

I, Ronald Bischer, in a field survey on 3-28, 1996, do hereby certify that under requirements of P.A. 74, Michigan P.A. of 1970, the corner points mentioned in lines 1 and 2 above were in conformance with regulations and rules therefore as required in the current manual of survey instructions of the United States Department of the Interior, Bureau of Land Management or by a decree of a Court of Law and/or that the corner points mentioned in lines 3, 4 and 5 above were in conformance with the rules of the Michigan Board of Professional Surveyors or by a Decree of a Court of Law; established, re-established, monumented, re-monumented, recovered, found as expressed below:


NOTE: Not more than 4 corners, all in the same town and range, may be recorded on this certificate.

A. Description of original monument and accessories and/or subsequent restoration:

E-5
 1856 Alfred Millend Set Wood Post
 N50°E 28 links 15" Beech
 S50°W 19 links 10" Sugar
 4-4-78 Delmar Porter Fd. 1" Rod (Scott), set 1/2" rod and Mon. box
 left 3 witnesses

B. Description of corner evidence found and/or method applied in restoring or reestablishing corner:

E-5
 3-28-96 Ronald Bischer found 1/2" Rod, set cap #22428, in Mon. box
 N46°W 80.69' P. pole
 N43°E 43.12' 10" Maple
 S30°E 47.69' 2" Maple

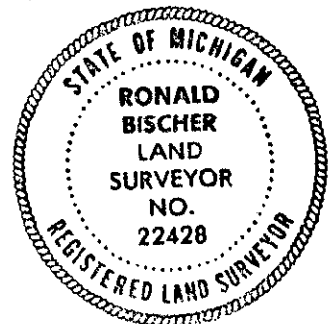

C. Description of monument for corner and accessories established to perpetuate locating the position of the corner:

E-5
 3-28-96 Ronald Bischer
 1/2" Rod & Cap in Mon. box. #22428
 N46°W 80.60' Power pole
 N43°E 43.12' 12" Maple
 S30°E 47.69' 8" Maple
 S57°W 81.07' 7" Spruce

Ratified by Peer Group
 in accordance with P.A. 345
 Chairman *Delmar Porter*
 Date 6/12/96

Signed by Ronald R. Bischer

Date 6-6-96

Surveyor's Michigan License No. 22428