

LAND CORNER RECORDATION CERTIFICATE
Filing Requirement of Act 74, Mich. P.A. 1970

For corners in Presque Isle Located In: Corner Code #
(County)

- | | | | | |
|--------------------------------------|---|------------|-------------|------------|
| 1. Public Land Survey | T | <u>34N</u> | <u>R 5E</u> | <u>E-6</u> |
| | T | _____ | R _____ | _____ |
| | T | _____ | R _____ | _____ |
| | T | _____ | R _____ | _____ |
| 2. Property Controlling in Section | S | _____ | T _____ | R _____ |
| | S | _____ | T _____ | R _____ |
| 3. Miscellaneous Property in Section | S | _____ | T _____ | R _____ |
| | S | _____ | T _____ | R _____ |
4. Lot No. _____, Recorded Plat _____
5. Private Claims _____

PRESQUE ISLE COUNTY
RECORDED

96 JUN 13 PM 12:23

Janet M. Seibert
REGISTER OF DEEDS

Register of Deeds Stamp & File Number

I, Ronald Bischer, in a field survey on 3-29, 1996, do hereby certify that under requirements of P.A. 74, Michigan P.A. of 1970, the corner points mentioned in lines 1 and 2 above were in conformance with regulations and rules therefore as required in the current manual of survey instructions of the United States Department of the Interior, Bureau of Land Management or by a decree of a Court of Law and/or that the corner points mentioned in lines 3, 4 and 5 above were in conformance with the rules of the Michigan Board of Professional Surveyors or by a Decree of a Court of Law; established, re-established, monumented, re-monumented, recovered, found as expressed below:

	A	B	C	D	E	F	G	H	I	J	K	L	M
2	6	5	4	3	2								
3													
4	7	6	5	4	3	2							
5													
6	18	17	16	15	14	13							
7													
8	19	20	21	22	23	24							
9													
10	30	29	28	27	26	25							
11													
12	31	32	33	34	35	36							
13													


NOTE: Not more than 4 corners, all in the same town and range, may be recorded on this certificate.

A. Description of original monument and accessories and/or subsequent restoration:

- E-6
1856 Alfred Millend Set Wood Post
S54°E 38 links 30" Elm
N30°W 20 links 36" Hemlock
4-4-78 Delmar Porter Fd. 1½" Pipe (Scott) 2.5' below surface, set ½" Rod & Mon. box. left 3 witnesses
6-14-89 Duane MacNeill Refers to corner as Fd. Mon. box.

B. Description of corner evidence found and/or method applied in restoring or reestablishing corner:

- E-6
3-29-96 Ronald Bischer found ½" rod & cap #15410 in Mon. box.
N32°E 65.76' 3" Apple
N73°W 30.00' Power pole

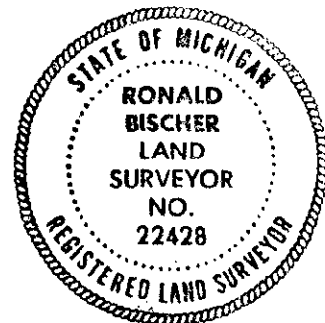

C. Description of monument for corner and accessories established to perpetuate locating the position of the corner:

- E-6
3-29-96 Ronald Bischer
½" Rod & Cap #15410 in Mon. box.
N41°E 65.76' 5" Apple
N73°W 30.00' Power pole
S32°E 97.78' 6" Cedar
S82°W 82.03' NE corner of house

Ratified by Peer Group
in accordance with P.A. 345
Chairman *Delmar Porter*
Date 6/12/96

Signed by Ronald R. Bischer

Date 6-6-96

Surveyor's Michigan License No. 22428