

10570

LAND CORNER RECORDATION CERTIFICATE  
Filing Requirement of Act 74, Mich. P.A. 1970

For corners in Presque Isle Located In: \_\_\_\_\_ Corner Code # \_\_\_\_\_  
(County)

- 1. Public Land Survey T 34N R 5E E-8  
T \_\_\_\_\_ R \_\_\_\_\_  
T \_\_\_\_\_ R \_\_\_\_\_  
T \_\_\_\_\_ R \_\_\_\_\_
- 2. Property Controlling S \_\_\_\_\_ T \_\_\_\_\_ R \_\_\_\_\_  
in Section S \_\_\_\_\_ T \_\_\_\_\_ R \_\_\_\_\_
- 3. Miscellaneous S \_\_\_\_\_ T \_\_\_\_\_ R \_\_\_\_\_  
Property in Section S \_\_\_\_\_ T \_\_\_\_\_ R \_\_\_\_\_

PRESQUE ISLE COUNTY  
RECORDED

96 JUN 13 PM 12: 22

*Jane M. Lamb*

REGISTER OF DEEDS

Register of Deeds Stamp & File Number

- 4. Lot No. \_\_\_\_\_, Recorded Plat \_\_\_\_\_
- 5. Private Claims \_\_\_\_\_

I, RONALD Bischer, in a field survey on 3-29, 19 96  
do hereby certify that under requirements of P.A. 74, Michigan P.A. of 1970, the corner points mentioned  
in lines 1 and 2 above were in conformance with regulations and rules therefore as required in the current  
manual of survey instructions of the United States Department of the Interior, Bureau of Land  
Management or by a decree of a Court of Law and/or that the corner points mentioned in lines 3, 4 and  
5 above were in conformance with the rules of the Michigan Board of Professional Surveyors or by a  
Decree of a Court of Law; established, re-established, monumented, re-monumented, recovered, found  
as expressed below:

A	B	C	D	E	F	G	H	I	J	K	L	M
2	6	5	4	3	2	1						
3												
4	7	6	5	4	3	2	1					
5												
6	18	17	16	15	14	13	12	11	10	9	8	7
7												
8	18	20	21	22	23	24	25	26	27	28	29	30
9												
10	30	29	28	27	26	25	24	23	22	21	20	19
11												
12	31	32	33	34	35	36						
13												

NOTE: Not more than 4 corners, all in the same town and range, may be recorded  
on this certificate.


A. Description of original monument and accessories and/or subsequent restoration:

E-8  
1856 Alfred Millend  
set wood post  
S15°W 9 links 18" Cedar  
N40°E 21 links 12" Cedar

1-7-92 Thomas Fabis set 1/2" rod & cap #31591  
left four witnesses

B. Description of corner evidence found and/or method applied in restoring or reestablishing corner:

E-8  
3-29-96 Ronald Bischer reset 1/2" rod & cap #22428 from  
witnesses. Left 4 witnesses

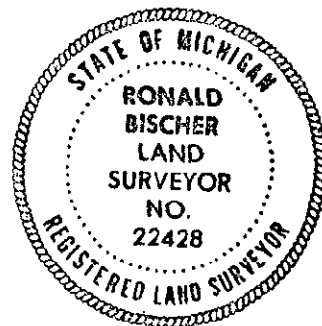

C. Description of monument for corner and accessories established to perpetuate locating the position of the corner:

E-8  
1/2" rod & cap #22428  
S45°E 25.23' 6" Balsam  
S45°W 15.60' 5" Cedar  
East 2.22' 6" y. Birch  
N40°W 17.60' 5" y. Birch

Ratified by Peer Group  
in accordance with P.A. 345

Chairman *Delmer Spotts*  
Date 6/12/96

Signed by Ronald R. Bischer

Date 6-6-96

Surveyor's Michigan License No. 22428