

LAND CORNER RECORDATION CERTIFICATE
Filing Requirement of Act 74, Mich. P.A. 1970

PRESQUE ISLE COUNTY
RECORDED

For corners in
Presque Isle
(County)

Located In:

Corner Code #

96 JUN 13 PM 12:22

- | | | | | | | |
|--------------------------------------|---|------------|---|-----------|-------------|-------|
| 1. Public Land Survey | T | <u>34N</u> | R | <u>5E</u> | <u>E-11</u> | |
| | T | _____ | R | _____ | _____ | |
| | T | _____ | R | _____ | _____ | |
| | T | _____ | R | _____ | _____ | |
| 2. Property Controlling in Section | S | _____ | T | _____ | R | _____ |
| | S | _____ | T | _____ | R | _____ |
| 3. Miscellaneous Property in Section | S | _____ | T | _____ | R | _____ |
| | S | _____ | T | _____ | R | _____ |

Janet M. Lambert
REGISTER OF DEEDS

Register of Deeds Stamp & File Number

4. Lot No. _____, Recorded Plat _____
5. Private Claims _____

I, Ronald Bischer, in a field survey on 3-13, 19 96, do hereby certify that under requirements of P.A. 74, Michigan P.A. of 1970, the corner points mentioned in lines 1 and 2 above were in conformance with regulations and rules therefore as required in the current manual of survey instructions of the United States Department of the Interior, Bureau of Land Management or by a decree of a Court of Law and/or that the corner points mentioned in lines 3, 4 and 5 above were in conformance with the rules of the Michigan Board of Professional Surveyors or by a Decree of a Court of Law; established, re-established, monumented, re-monumented, recovered, found as expressed below:

	A	B	C	D	E	F	G	H	I	J	K	L	M
2	6		5					8		2			
3													
4	7		8		9		10		11		12		
5													
6	18		17		16		15		14		13		
7													
8	19		20		21		22		23		24		
9													
10	30		29		28		27		26		25		
11													
12	31		32		33		34		35		36		
13													


NOTE: Not more than 4 corners, all in the same town and range, may be recorded on this certificate.

A. Description of original monument and accessories and/or subsequent restoration:

- E-11
1856 Alfred Millend Set Wood Post
N38°E 30 links 8" Tamarack
S60°W 23 links 12" Tamarack
8-9-78 Delmar Porter Found Cedar stake from Loud's notes set 1/2" Rod. left 3 witnesses

B. Description of corner evidence found and/or method applied in restoring or reestablishing corner:

- E-11
3-13-96 Ronald Bischer found 1/2" Rod & 4"x4" Cedar stake
N30°W 37.99' 4" Tamarack
N51°E 47.11' 7" Tamarack
S02°E 38.13' 10" Cedar

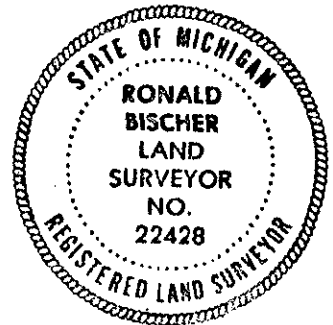

C. Description of monument for corner and accessories established to perpetuate locating the position of the corner:

- E-11
3-13-96 Ronald Bischer
1/2" rod & 4"x4" Cedar stake
N30°W 37.99' 7" Tamarack
N46°E 47.11' 11" Tamarack
S02°E 37.70' 10" Cedar
S17°W 43.60' 14" Cedar

Ratified by Peer Group
in accordance with P.A. 345
Chairman *Delmar Porter*
Date 6/12/96

Signed by Ronald E. Bischer

Date 6-6-96

Surveyor's Michigan License No. 22428