

#1045

LAND CORNER RECORDATION CERTIFICATE
Filing Requirement of Act 74, Mich. P.A. 1970

For corners in Presque Isle Located In: _____ Corner Code # _____
(County)

- 1. Public Land Survey T 34N R 5E E-13
T _____ R _____
T _____ R _____
T _____ R _____
- 2. Property Controlling S _____ T _____ R _____
in Section S _____ T _____ R _____
- 3. Miscellaneous S _____ T _____ R _____
Property in Section S _____ T _____ R _____
- 4. Lot No. _____, Recorded Plat _____
- 5. Private Claims _____

PRESQUE ISLE COUNTY
RECORDED

96 JUN 13 PM 12:21

Jane M. Lamb
REGISTER OF DEEDS

Register of Deeds Stamp & File Number

I, Ronald Bischer, in a field survey on 3-13, 19 96, do hereby certify that under requirements of P.A. 74, Michigan P.A. of 1970, the corner points mentioned in lines 1 and 2 above were in conformance with regulations and rules therefore as required in the current manual of survey instructions of the United States Department of the Interior, Bureau of Land Management or by a decree of a Court of Law and/or that the corner points mentioned in lines 3, 4 and 5 above were in conformance with the rules of the Michigan Board of Professional Surveyors or by a Decree of a Court of Law; established, re-established, monumented, re-monumented, recovered, found as expressed below:

NOTE: Not more than 4 corners, all in the same town and range, may be recorded on this certificate.


	A	B	C	D	E	F	G	H	I	J	K	L	M
2	6		5		4		3		2		1		
3													
4	7		8		9		10		11		12		
5													
6	18		17		16		15		14		13		
7													
8	19		20		21		22		23		24		
9													
10	30		29		28		27		26		25		
11													
12	31		32		33		34		35		36		
13													

A. Description of original monument and accessories and/or subsequent restoration:

E-13
1840 John Hodgson Set Wood Post
N82°E 17 links 10" Maple
N80°W 19 links 7" Maple
8-16-79 Delmar Porter Rd. 1/2" rod, set Presque Isle County Remonumentation Monument. left 2 witnesses
Recorded by R. Bischer on 8-9-79 with same information.
10-23-89 Ronald Bischer found 1/2" rod. left 5 witnesses
4-8-94 Ronald Bischer found 1/2" rod, left 4 witnesses

B. Description of corner evidence found and/or method applied in restoring or reestablishing corner:

E-13
3-13-96 Ronald Bischer found 1/2" Rod, set Cap #22428
N36°E 55.33' Power pole
N30°W 81.90' 7" Pine

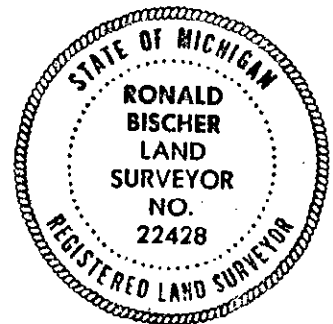

C. Description of monument for corner and accessories established to perpetuate locating the position of the corner:

E-13
3-13-96 Ronald Bischer
1/2" Rod & Cap #22428
S63°E 74.40' Tele. Cable Box
N33°E 55.21' Power pole
N00°E 64.01' 10" Pine
N27°W 81.56' 7" Pine

Ratified by Peer Group
in accordance with P.A. 345

Chairman *Delmar Porter*

Date 6/12/96

Signed by Ronald R. Bischer

Date 6-6-96

Surveyor's Michigan License No. 22428