

1265

1996 PRESQUE ISLE COUNTY, STATE OF MICHIGAN REMONUMENTATION

LAND CORNER RECORDATION CERTIFICATE
Filing Requirement of Act 74, Mich. P.A. 1970

LIBER 319 PAGE 112

For corners in

<u>Presque Isle</u> (County)	Located In:	Corner Code #
1. Public Land Survey	T <u>34N</u> R <u>5E</u>	<u>F-5</u>
	T <u> </u> R <u> </u>	<u> </u>
	T <u> </u> R <u> </u>	<u> </u>
	T <u> </u> R <u> </u>	<u> </u>
2. Property Controlling in Section	S <u> </u> T <u> </u> R <u> </u>	<u> </u>
	S <u> </u> T <u> </u> R <u> </u>	<u> </u>
3. Miscellaneous Property in Sec.	S <u> </u> T <u> </u> R <u> </u>	<u> </u>
	S <u> </u> T <u> </u> R <u> </u>	<u> </u>

PRESQUE ISLE COUNTY
RECORDED

95 JUL 12 AM 11:38

Janet M. Slamb
REGISTER OF DEEDS

Register of Deeds Stamp & File Number

4. Lot No. _____, Recorded Plat _____
5. Private Claims _____

I, James A. Beck, in a field survey on April 23, 1996 do hereby state that under requirements of P.A. 74, Michigan P.A. of 1970, the corner points mentioned in lines 1 and 2 above were in conformance with regulations and rules therefore as required in the current manual of survey instructions of the United States Department of the Interior, Bureau of Land Management or by a decree of a Court of Law and/or that the corner points mentioned in lines 3, 4 and 5 above were in conformance with the rules of the Michigan Board of Land Surveyors or by a Decree of a Court of Law; established, re-established, monumented, recovered, found as expressed below:

NOTE: Not more than 2 corners, all in the same town and range, may be recorded on this certificate.

A	B	C	D	E	F	G	H	I	J	K	L	M
1												
2	6		5		4		3		2		1	
3												
4	7		8		9		10		11		12	
5					⊕							
6	18		17		16		15		14		13	
7												
8	19		20		21		22		23		24	
9												
10	30		29		28		27		26		25	
11												
12	31		32		33		34		35		36	
13												

A. Description of original monument and accessories and/or subsequent restoration:

F-5	G.L.O. 1856 Alfred Millerd	"Set 1/4 Sec. Post" B. Ash 7 S22W 7 Cedar 6 N5E 19	July 15, 1993 P.A. 132 Survey by J. Beck Reg. No. 21559
	Dec. 12, 1988 P.A. 132 Survey by Delmer Porter Reg. No. 15410	1/2" Rod & L.L.S. Cap 15410 N31°W 22.03' 16" W. Pine N28°E 28.82' 14" Spruce S10°E 4.88' 14" Cedar	Fd. R.L.S. 15410 iron and cap Witnesses S 50°W 15.61' P.K. nail in 8" Cedar N 35°W 22.10', R.L.S. 15410 tag in 14" Pine S 45°E 21.03', P.K. nail in 6" Cedar N 30°E 28.86' R.L.S. 15410 tag in 10" Spruce S 55°E 36.6' 12" Pine stump with blaze

B. Description of corner evidence found and/or method applied in restoring or reestablishing corner:

F-5
1996 Remonumentation
by James A. Beck
P.S. 21559


FOUND R.L.S. 15410 iron and cap
Witnesses:
S 50°W 15.61' P.S.21559 tag in 8" Cedar
N 35°W 22.10', R.L.S. 15410 tag in 14" Pine
S 35°E 21.03', P.S. 21559 tag in 6" Cedar (previously recorded "S 45°E")
N 30°E 28.86' R.L.S. 15410 tag in 10" Spruce
S 55°E 36.6' 12" Pine stump with blaze
S 10°E 4.88' Cedar stump with blaze

Ratified by Peer Group
in accordance with P.A. 345
Delmer Porter
Date 5/22/96

C. Description of monument for corner and accessories established to perpetuate locating the position of the corner:

F-5
1996 Remonumentation
by James A. Beck
P.S. 21559

R.L.S. 15410 iron and cap
Witnesses:
S 50°W 15.61' P.S.21559 tag in 8" Cedar
N 35°W 22.10', R.L.S. 15410 tag in 14" Pine
S 35°E 21.03', P.S. 21559 tag in 6" Cedar (previously recorded "S 45°E")
N 30°E 28.86' R.L.S. 15410 tag in 10" Spruce
S 55°E 36.6' 12" Pine stump with blaze
S 10°E 4.88' Cedar stump with blaze

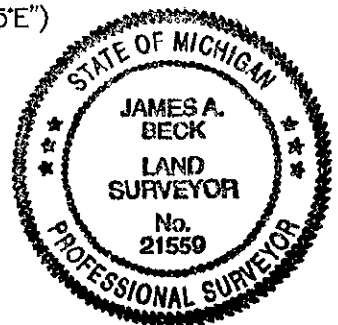

Signed by *James A. Beck*
Surveyor's Michigan License No. 21559

Date June 17, 1996