

1272

1996 PRESQUE ISLE COUNTY, STATE OF MICHIGAN REMONUMENTATION

LAND CORNER RECORDATION CERTIFICATE  
Filing Requirement of Act 74, Mich. P.A. 1970

LIBER 319 PAGE 119

For corners in

<u>Presque Isle</u> (County)	Located In:	Corner Code #
1. Public Land Survey	T 34N R 5E	G4
	T R	
	T R	
	T R	
2. Property Controlling in Section	S T R	
	S T R	
3. Miscellaneous Property in Sec.	S T R	
	S T R	

PRESQUE ISLE COUNTY  
RECORDED

96 JUL 12 AM 11:40

*Janet M. Lamb*  
REGISTER OF DEEDS

Register of Deeds Stamp & File Number

4. Lot No. \_\_\_\_\_, Recorded Plat \_\_\_\_\_  
5. Private Claims \_\_\_\_\_

I, James A. Beck, in a field survey on May 6, 1996 do hereby state that under requirements of P.A. 74, Michigan P.A. of 1970, the corner points mentioned in lines 1 and 2 above were in conformance with regulations and rules therefore as required in the current manual of survey instructions of the United States Department of the Interior, Bureau of Land Management or by a decree of a Court of Law and for that the corner points mentioned in lines 3, 4 and 5 above were in conformance with the rules of the Michigan Board of Land Surveyors or by a Decree of a Court of Law, established, re-established, monumented, recovered, found as expressed below:

A	B	C	D	E	F	G	H	I	J	K	L	M
1												
2	6		5		4		3		2		1	
3												
4	7		8		9	10		11		12		
5												
6	18		17		16		15		14		13	
7												
8	19		20		21		22		23		24	
9												
10	30		29		28		27		26		25	
11												
12	31		32		33		34		35		36	
13												

NOTE: Not more than 2 corners, all in the same town and range, may be recorded on this certificate.

A. Description of original monument and accessories and/or subsequent restoration:

G-4  
G.L.O. 1856 Alfred Millerd " Set qr. Sec. post Cedar 10 N72°W 30 Cedar 6 S72E 22

Mar. 29, 1982 P.A. 74 Recordation by Ronald Bischer Reg. No. 22428 1/2" rod & cap N 72°W 20.00' 12" cedar S53°W 12.78' 6" Cedar S63°E 7.45' 4" Cedar R. Bischer " Found original Bearing trees and stream location. Set 1/2" rod"

B. Description of corner evidence found and/or method applied in restoring or reestablishing corner:

G-4  
1996 Remonumentation by James A. Beck P.S. 21559 found 1/2" rod & 15410 cap N 72°W 20.00' 12" cedar S53°W 12.78' 6" Cedar S63°E 7.45' 4" Cedar ( wind felled )


Ratified by Peer Group in accordance with P.A. 345

Chairman *James A. Beck*  
Date 5/22/96

C. Description of monument for corner and accessories established to perpetuate locating the position of the corner:

G-4  
1996 Remonumentation by James A. Beck P.S. 21559 1/2" rod & 15410 cap N 72°W 20.00' 12" cedar S53°W 12.78' 6" Cedar S63°E 7.45' 4" Cedar ( wind felled )  
N 27°E 6.47' 3" Cedar  
S 34°E 25.65' 4" Cedar

old tags grown over, set P.S. 21559 tags in standing witness trees

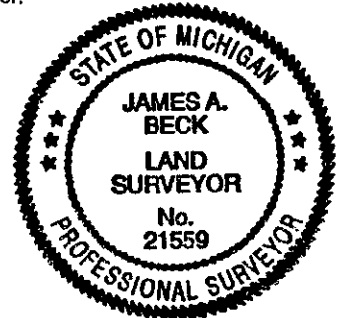

Signed by *James A. Beck*  
Surveyor's Michigan License No. 21559

Date June 17, 1996