

12/14

1996 PRESQUE ISLE COUNTY, STATE OF MICHIGAN REMONUMENTATION

LAND CORNER RECORDATION CERTIFICATE  
Filing Requirement of Act 74, Mich. P.A. 1970

LIBER 319 PAGE 121

For corners in

|                                       |                           |               |
|---------------------------------------|---------------------------|---------------|
| <u>Presque Isle</u><br>(County)       | Located In:               | Corner Code # |
| 1. Public Land Survey                 | T <u>34</u> N R <u>5E</u> | <u>G-6</u>    |
|                                       | T ___ R ___               | _____         |
|                                       | T ___ R ___               | _____         |
|                                       | T ___ R ___               | _____         |
| 2. Property Controlling<br>in Section | S ___ T ___ R ___         | _____         |
|                                       | S ___ T ___ R ___         | _____         |
| 3. Miscellaneous<br>Property in Sec.  | S ___ T ___ R ___         | _____         |
|                                       | S ___ T ___ R ___         | _____         |

PRESQUE ISLE COUNTY  
RECORDED

96 JUL 12 AM 11:40

*Jana M. Lamb*  
REGISTER OF DEEDS

Register of Deeds Stamp & File Number

4. Lot No. \_\_\_\_\_, Recorded Plat \_\_\_\_\_  
5. Private Claims \_\_\_\_\_

I, James A. Beck, in a field survey on Feb 22, 1996 do hereby state that under requirements of P.A. 74, Michigan P.A. of 1970, the corner points mentioned in lines 1 and 2 above were in conformance with regulations and rules therefore as required in the current manual of survey instructions of the United States Department of the Interior, Bureau of Land Management or by a decree of a Court of Law and/or that the corner points mentioned in lines 3, 4 and 5 above were in conformance with the rules of the Michigan Board of Land Surveyors or by a Decree of a Court of Law, established, re-established, monumented, recovered, found as expressed below:

NOTE: Not more than 2 corners, all in the same town and range, may be recorded on this certificate.

|    | A  | B | C  | D | E  | F | G  | H | I  | J | K  | L | M |
|----|----|---|----|---|----|---|----|---|----|---|----|---|---|
| 1  |    |   |    |   |    |   |    |   |    |   |    |   |   |
| 2  | 6  |   | 5  |   | 4  |   | 3  |   | 2  |   | 1  |   |   |
| 3  |    |   |    |   |    |   |    |   |    |   |    |   |   |
| 4  | 7  |   | 8  |   | 9  |   | 10 |   | 11 |   | 12 |   |   |
| 5  |    |   |    |   |    |   |    |   |    |   |    |   |   |
| 6  | 18 |   | 17 |   | 16 |   | 15 |   | 14 |   | 13 |   |   |
| 7  |    |   |    |   |    |   |    |   |    |   |    |   |   |
| 8  | 19 |   | 20 |   | 21 |   | 22 |   | 23 |   | 24 |   |   |
| 9  |    |   |    |   |    |   |    |   |    |   |    |   |   |
| 10 | 30 |   | 29 |   | 28 |   | 27 |   | 26 |   | 25 |   |   |
| 11 |    |   |    |   |    |   |    |   |    |   |    |   |   |
| 12 | 31 |   | 32 |   | 33 |   | 34 |   | 35 |   | 36 |   |   |
| 13 |    |   |    |   |    |   |    |   |    |   |    |   |   |

A. Description of original monument and accessories and/or subsequent restoration:

|     |   |  |   |
|-----|---|--|---|
| G-6 | G.L.O. 1856<br>Alfred Millerd<br><br>" Set or. Sec. post"<br>Elm 14 N55E 45<br>Y Birch 12 S65W 21 | May 14, 1979<br>P.A. 74 Recordation<br>by Jerry Wilcox<br>Reg. No. 14102<br>Set 1/2" rerod with cap,<br>S.P. between section corners | Witnesses:<br>S 80°W, 4" Maple 31.69'<br>N 75°E, Ctr 6" Steel Gate Post 37.9'<br>N 45°E Ctr 6" Steel Gate Post 48.9'<br>"" 3' South of East and West Fence to East<br>and 36' West of Corner Post. "" |
|-----|---|--|---|

B. Description of corner evidence found and/or method applied in restoring or reestablishing corner:


G-6

|  |  |   |
|--|--|---|
| 1996 Remonumentation<br>by James A. Beck | Found 1/2" iron and RLS 14102 cap mutilated, set 21559 cap on iron   | Witnessed by Peer Group<br>in accordance with P.A. 345<br><i>James A. Beck</i><br>Date <u>5/22/96</u> |
|  | Witnesses:<br>S 80°W 31.69' 7" Maple<br>N 82°E 37.8' top center of 6" steel gate post<br>N 53°E 48.90' top center 6" steel gate post |   |

C. Description of monument for corner and accessories established to perpetuate locating the position of the corner:

G-6

|  |   |
|--|---|
| 1996 Remonumentation<br>by James A. Beck | 1/2" iron and 21559 cap   |
|  | Corner falls at center of gravel turn around and 2 rut road North and is 3' + or - Sly of fence Easterly extended   |
|  | Witnesses:<br>S 80°W 31.69' 7" Maple ( found nail, set 21559 tag )<br>N 82°E 37.8' top center of 6" steel gate post<br>N 53°E 48.90' top center 6" steel gate post<br>N 50°W 42.98' 21559 tag in 3" Maple |

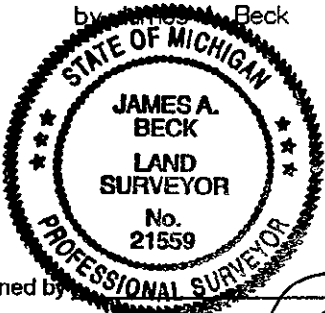

Signed by *James A. Beck* Date June 17, 1996  
Surveyor's Michigan License No. 21559