

1280

1996 PRESQUE ISLE COUNTY, STATE OF MICHIGAN REMONUMENTATION

LAND CORNER RECORDATION CERTIFICATE
Filing Requirement of Act 74, Mich. P.A. 1970

LIBER 319 PAGE 127

For corners in

Presque Isle
(County)

Located In:

Corner Code #

1. Public Land Survey

T 34N R 5E G-10
T R
T R
T R

2. Property Controlling in Section

S T R
S T R
S T R
S T R

3. Miscellaneous Property in Sec.

PRESQUE ISLE COUNTY
RECORDED

96 JUL 12 AM 11:41

Janet M. Lamb
REGISTER OF DEEDS

Register of Deeds Stamp & File Number

4. Lot No. , Recorded Plat
5. Private Claims

I, James A. Beck, in a field survey on Mar 11, 1996 do hereby state that under requirements of P.A. 74, Michigan P.A. of 1970, the corner points mentioned in lines 1 and 2 above were in conformance with regulations and rules therefore as required in the current manual of survey instructions of the United States Department of the Interior, Bureau of Land Management or by a decree of a Court of Law and/or that the corner points mentioned in lines 3, 4 and 5 above were in conformance with the rules of the Michigan Board of Land Surveyors or by a Decree of a Court of Law; established, re-established, monumented, recovered, found as expressed below:

NOTE: Not more than 2 corners, all in the same town and range, may be recorded on this certificate.

Grid table with columns A-M and rows 1-13. Cell (10, F) contains a circled '1'.

A. Description of original monument and accessories and/or subsequent restoration:

G-10 Dec. 9, 1976 Survey Recorded
G.L.O. 1856 P.A. 132 Survey Liber 215, Page 882
Alfred Millerd by Delmer Porter
" Set qr Sec. post " Reg. No. 15410
Beech 8 N15E 15 WEST 1/4 Cor
Beech 8 S17W 21 PK Nail in road
N 23°W 71.98' Power pole
S 80°W 40.55' 16" Maple

PART "A" CONTINUED ON REVERSE SIDE

B. Description of corner evidence found and/or method applied in restoring or reestablishing corner:


G-10 1996 Remonumentation found 1/2" iron with 15410 cap
by James A. Beck in monument box
Witness:
N 23W 71.91' 15410 tag in power pole

Ratified by Peer Group
in accordance with P.A. 945

Chairman [Signature]
Date 5/22/96

C. Description of monument for corner and accessories established to perpetuate locating the position of the corner:

G-10 1996 Remonumentation found 1/2" iron with 15410 cap
by James A. Beck in monument box
corner falls in tar surface road North and South
2' + or - East of centerline
N 23W 71.91' 15410 tag in power pole
S 59°W 94.18' SE cor house, corner of trim
S 72°W 81.82' NE cor house, corner of trim
S 79°W 115.94' NW cor house, corner of trim
S 26°W 96.95' P.S.21559 tag in 5" deciduous tree

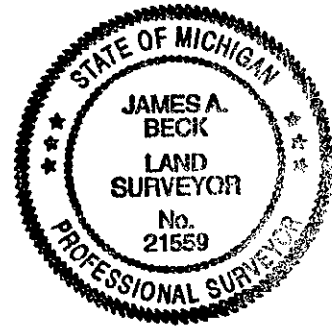

Signed by [Signature]
Surveyor's Michigan License No. 21559

Date June 17, 1996

PART "A" CONTINUED CORNER G-10

Dec. 12, 1976
P.A. 74 Recordation
by Ronald Bischer
Reg. No. 22428

Set P.K. nail in line with
fences on Sec. line
Witnesses:
N 23°W 71.98' Power pole
S 80°W 40.55' 16" Maple

Sep. 25, 1978
P.A. 74 Recordation
by Delmer Porter
Reg. No. 15410

1/2" rod and cap in Mon. Box
Witnesses:
N 23°W 71.98' Power pole
S 80°W 40.55' 16" Maple

D. Porter apparently
set 1/2" rod and cap
in Mon. Box at last
Recordation location

Jan 4, 1980
P.A. 132 Survey
by Delmer Porter
Reg. No. 15410

" West 1/4 cor.
PK nail in road "
Witnesses:
N 23°W 71.98' Power pole
S 80°W 40.55' 16" Maple

Survey Recorded
Liber 234, Page 450