

279

1996 PRESQUE ISLE COUNTY, STATE OF MICHIGAN REMONUMENTATION

LAND CORNER RECORDATION CERTIFICATE
Filing Requirement of Act 74, Mich. P.A. 1970

For corners in
Presque Isle
(County)

Located In:	Corner Code #
T 34 N R 5 E	G-13
T R	
T R	
T R	
S T R	
S T R	
S T R	
S T R	

PRESQUE ISLE COUNTY
RECORDED
96 JUL 12 AM 11:41
Janet M. Lamb
REGISTER OF DEEDS
Register of Deeds Stamp & File Number

- 1. Public Land Survey
- 2. Property Controlling in Section
- 3. Miscellaneous Property in Sec.
- 4. Lot No. _____, Recorded Plat _____
- 5. Private Claims _____

James A. Beck, in a field survey on Mar 11, 1996 do hereby state that under requirements of P.A. 74, Michigan P.A. of 1970, the corner points mentioned in lines 1 and 2 above were in conformance with regulations and rules therefore as required in the current manual of survey instructions of the United States Department of the Interior, Bureau of Land Management or by a decree of a Court of Law and/or that the corner points mentioned in lines 3, 4 and 5 above were in conformance with the rules of the Michigan Board of Land Surveyors or by a Decree of a Court of Law; established, re-established, monumented, recovered, found as expressed below.

NOTE: Not more than 2 corners, all in the same town and range, may be recorded on this certificate.

	A	B	C	D	E	F	G	H	I	J	K	L	M
1													
2	6		5		4		3		2		1		
3													
4	7		8		9		10		11		12		
5													
6	18		17		16		15		14		13		
7													
8	19		20		21		22		23		24		
9													
10	30		29		28		27		26		25		
11													
12	31		32		33		34		35		36		
13													

A. Description of original monument and accessories and/or subsequent restoration:

G-13
 G.L.O. 1840
 John Hodgson
 "Set post cor. Sections 33 and 34 in swamp"
 Cedar 7 N 7'E 3
 do 8 N34W 33
 Sep 25, 1978
 P.A. 74 Recordation by Delmer Porter
 Reg. No. 15410
 1/2" rod in Mon. Box
 Witnesses:
 N 40°W 44.23' Fe. Cor.
 N 31°E 72.02' 6" W. Pine
 S 21°E 87.45' 4" Elm
 D. Porter
 " Found P.K. Nail in intersection and witness tags in P. pole to the NW. and 4" White Pine to the NE."


B. Description of corner evidence found and/or method applied in restoring or reestablishing corner:

G-13 1996 Remonumentation by James A. Beck
 found 1/2" iron rod in monument box
 Witnesses:
 N 40°W 44' + or -, fence corner lying down
 S 21°E 87.45', 21559 tag in 6" Elm (old tag grown over)

Ratified by Peer Group in accordance with P.A. 345
 Chairman *Delmer Porter*
 Date 5/22/96

C. Description of monument for corner and accessories established to perpetuate locating the position of the corner:

G-13 1996 Remonumentation by James A. Beck
 1/2" iron rod and P.S. 21559 cap in monument box
 corner falls at center of paved roads North, East, and West, and 5' + or - Westerly of gravel road to South
 Witnesses:
 N 40°W 44' + or -, fence corner lying down
 S 21°E 87.45', 21559 tag in 6" Elm (old tag grown over)
 N 62°W 100.78' 21559 tag in power pole
 N 32°E 111.34' 21559 tag in 3" cedar
 S 23°W 127.83' near corner top of underground cable marker post

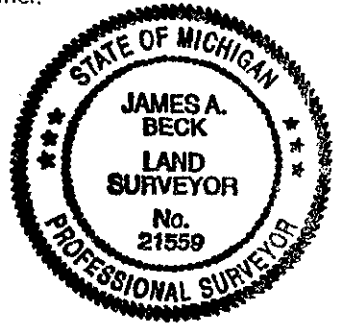

Signed by *James A. Beck*
 Surveyor's Michigan License No. 21559

Date June 17, 1996