

2602-

1997 PRESQUE ISLE COUNTY STATE OF MICHIGAN REMONUMENTATION

LAND CORNER RECORDATION CERTIFICATE LIBER 325 PAGE 081
Filing Requirement of Act 74, Mich. P.A. 1970

For corners in

Presque Isle
(County)

Located In: Belknap Twp. Corner Code #

1. Public Land Survey	T	34N	5E	H7
	T	___	R	___
	T	___	R	___
	T	___	R	___
2. Property Controlling in Section	S	___	T	___
	S	___	T	___
3. Miscellaneous Property in Sec.	S	___	T	___
	S	___	T	___

PRESQUE ISLE COUNTY
RECORDED

97 DEC 18 AM 9:55

Janet M. Slom
REGISTER OF DEEDS

Register of Deeds Stamp & File Number

4. Lot No. _____, Recorded Plat _____
5. Private Claims _____

I, James A. Beck, in a field survey on Oct. 30, 1997 do hereby state that under requirements of P.A. 74, Michigan P.A. of 1970, the corner points mentioned in lines 1 and 2 above were in conformance with regulations and rules therefore as required in the current manual of survey instructions of the United States Department of the Interior, Bureau of Land Management or by a decree of a Court of Law and /or that the corner points mentioned in lines 3, 4 and 5 above were in conformance with the rules of the Michigan Board of Land Surveyors or by a Decree of a Court of Law; established, re-established, monumented, recovered, found as expressed below.

NOTE: Not more than 2 corners, all in the same town and range, may be recorded on this certificate.

1	A	B	C	D	E	F	G	H	I	J	K	L
2		6		5		4		3		2		1
3												
4		7		8		9		10		11		12
5												
6		18		17		16		15		14		13
7												
8		19		20		21		22		23		24
9												
10		30		29		28		27		26		25
11												
12		31		32		33		34		35		36
13												

A. Description of original monument and accessories and/or subsequent restoration:

H7 GLO Alfred Millerd
"Set qr. Sec. post"
Cedar 12 S68W 5
Hemlock 12 N19E 11

SEE REVERSE SIDE OF CERTIFICATE FOR FURTHER ACTIVITY
AT CORNER

B. Description of corner evidence found and/or method applied in restoring or reestablishing corner:

H7 Found 1/2" iron rod with P.S. 21559 cap in monument box

SURVEY &
REMONUMENTATION

JAN 14 1998

SECTION


C. Description of monument for corner and accessories established to perpetuate locating the position of the corner:

H7 1/2" iron rod with P.S. 21559 cap in monument box

Accessories:
 N 2°E 47.85 ft. 2" Cedar
 S 68°E 97.11 ft. 6" Elm
 S 22°W 38.56 ft. 13" Poplar
 N 47°W 67.22 ft. 4" Cedar
 S 64°W 89.56 ft., 8" Tamarack

Ratified by Peer Group
 in accordance with P.A. 345
 Chairman Norman A. Acasini
 Date 11/13/97

All witnesses have P.S. 21559 tags

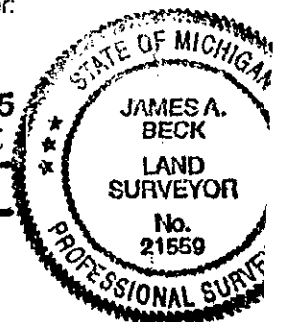

Corner falls at center of blacktop road East and West opposite brushed line to North.

Signed by James A. Beck
Surveyor's Michigan License No. 21559

Date 12/18/1997

PART "A" OF CERTIFICATE CONTINUED

LIBER 325 PAGE 082

September 25, 1978 P.A. 74 (Land Corner Recordation Certificate) by Delmer E. Porter Reg. No. 15410
Part A. " P.K. Nail (Scott)
N 03°E 51.70' 3" Ash
N 30°W 62.18 6" Poplar
Part B. Set ½" Rod & Cap by Single Proportion
Part C. ½" Rod & Cap in Mon. Box
N41°W 59.51', 8" Aspen
Due North 42.93', 12" Aspen
N 50°E 63.41' 8" Aspen

June 27, 1996 P.A. 132 Survey by James A. Beck Reg. No. 21559
Found ½" iron rod in monument box
set P.S. 21559 cap on iron
Accessories:
N 2°E 47.85 ft. 2" Cedar
S 68°E 97.11 ft. 6" Elm
S 22°W 38.56 ft. 13" Poplar
N 47°W 67.22 ft. 4" Cedar