

Ja A. Beck
2604

1997 PRESQUE ISLE COUNTY STATE OF MICHIGAN REMONUMENTATION

LAND CORNER RECORDATION CERTIFICATE
Filing Requirement of Act 74, Mich. P.A. 1970

LIBER 325 PAGE 085

For corners in

Presque Isle

(County)

Located In:

Corner Code #

Belknap Twp.

T 34N 5E

H 11

1. Public Land Survey

T R

T R

T R

T R

2. Property Controlling in Section

S T R

S T R

3. Miscellaneous Property in Sec.

S T R

S T R

4. Lot No. _____, Recorded Plat _____

5. Private Claims _____

PRESQUE ISLE COUNTY
RECORDED

97 DEC 18 AM 9:55

James M. Beck
REGISTER OF DEEDS

Register of Deeds Stamp & File Number

I, _____, in a field survey on Oct. 30, 1997 do hereby state that under requirements of P.A. 74, Michigan P.A. of 1970, the corner points mentioned in lines 1 and 2 above were in conformance with regulations and rules therefore as required in the current manual of survey instructions of the United States Department of the Interior, Bureau of Land Management or by a decree of a Court of Law and/or that the corner points mentioned in lines 3, 4 and 5 above were in conformance with the rules of the Michigan Board of Land Surveyors or by a Decree of a Court of Law; established, re-established, monumented, recovered, found as expressed below:

	A	B	C	D	E	F	G	H	I	J	K	L	M
1													
2	6			5				4			3		2
3													
4	7			8				9			10		11
5													
6	18			17				16			15		14
7													
8	19			20				21			22		23
9													
10	30			29				28			27		26
11													
12	31			32				33			34		35
13													

NOTE: Not more than 2 corners, all in the same town and range, may be recorded on this certificate.

A. Description of original monument and accessories and/or subsequent restoration:

Date: 1856 G.L.O. by Alfred Millerd
"Set 1/4 Sec. post"
Beech 10 S30W 10
Beech 6 N25E 14

Date: Dec. 20, 1976 P.A. 74 (Land Corner Recordation) Certificate,
page 168 by Ronald Bischer Reg. No.. 22428
Part A: no entry
Part B: "set spike in line with fences to North & South in CL of Road"
Part C: Monument "Spike"; Accessories: N02°E 28.96' Fe. cor.
S02°W 28.59' Fe. cor.; N81°E 112.21' power pole

B. Description of corner evidence found and/or method applied in restoring or reestablishing corner:

H 11
Found 1/2" iron rod, set P.S. 21559 cap on iron
Accessories:
N 2°E 29.33 ft., R.L.S. 15410 tag in leaning fence post

**SURVEY &
REMONUMENTATION**


JAN 14 1998

SECTION

C. Description of monument for corner and accessories established to perpetuate locating the position of the corner:

H 11
1/2" iron rod, set P.S. 21559 cap on iron
Accessories
N 2°E 29.33 ft., R.L.S. 15410 tag in leaning fence post
N 81°E 112.44 ft., R.L.S. 15410 tag in Power pole
N 25°E 87.22 ft., SW corner house foundation
N 51°E 119.74 ft., SE corner house foundation
Corner falls in gravel road 4' North of center of surface

Ratified by Peer Group
in accordance with P.A. 345
Chairman *Norman J. Brown*
Date 11/13/97

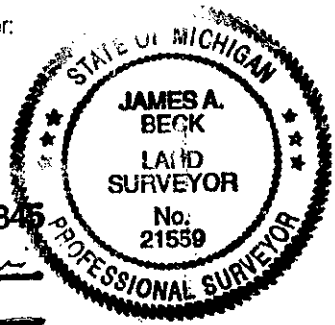

Signed by *James A. Beck*
Surveyor's Michigan License No. 21559

Date 12/8/1997