

JAN 14 1998

1997 PRESQUE ISLE COUNTY STATE OF MICHIGAN REMONUMENTATION

LIBER 325 PAGE 089

LAND CORNER RECORDATION CERTIFICATE  
Filing Requirement of Act 74, Mich. P.A. 1970

For corners in

Presque Isle (County)	Located In: Belknap Twp.	Corner Code # 1 2
1. Public Land Survey	T 34N R 5E	
	T R	
	T R	
	T R	
2. Property Controlling in Section	S T R	
	S T R	
3. Miscellaneous Property in Sec.	S T R	
	S T R	

PRESQUE ISLE COUNTY

97 DEC 18 AM 9:56

*Janet M. Lamb*  
REGISTER OF DEEDS

Register of Deeds Stamp & File Number

4. Lot No. \_\_\_\_\_, Recorded Plat \_\_\_\_\_  
5. Private Claims \_\_\_\_\_

I, James A. Beck, in a field survey on Oct. 30, 1997 do hereby state that under requirements of P.A. 74, Michigan P.A. of 1970, the corner points mentioned in lines 1 and 2 above were in conformance with regulations and rules therefore as required in the current manual of survey instructions of the United States Department of the Interior, Bureau of Land Management or by a decree of a Court of Law and/or that the corner points mentioned in lines 3, 4 and 5 above were in conformance with the rules of the Michigan Board of Land Surveyors or by a Decree of a Court of Law; established, re-established, monumented, recovered, found as expressed below:

NOTE: Not more than 2 corners, all in the same town and range, may be recorded on this certificate.

1	A	B	C	D	E	F	G	H	I	J	K	L	M
2	6		5		4		3		2		1		
3													
4	7		8		9		10		11		12		
5													
6	16		17		16		15		14		13		
7													
8	19		20		21		22		23		24		
9													
10	30		29		28		27		26		25		
11													
12	31		32		33		34		35		36		
13													

A. Description of original monument and accessories and/or subsequent restoration:

12  
1856 G.L.O. by Alfred Millerd  
" Set qr. Sec. post"  
Cedar 12 S35W 15  
Y Birch 12 N58E 18

March 26, 1981 P.A. 74 (Land Corner Recordation) Certificate  
page 526 by Ronald Bischer Reg. No. 22428  
Reset corner by S.P. in accordance  
with Survey by R. Alanen, R.L.S."  
" 1/2" Rod & RLS Cap.  
N55°W 67.05' 7" Maple; N72°W 67.49' 9" Cedar  
N76°E 49.51' 5" Cedar (SEE REVERSE SIDE)

B. Description of corner evidence found and/or method applied in restoring or reestablishing corner:

12


Monument:  
Found 1/2" iron rod, set P.S. 21559 cap on iron  
N58°W 66.77 ft., P.S. 21559 tag in 10" Maple (previous witness old tag grown over)  
N 73°W 67.28 ft., " " " in N. stem twin 12" Cedar ( previous witness, old tag grown over)

Ratified by Peer Group  
in accordance with P.A. 848  
Chairman *Norman J. Quinn*  
Date 4/13/97

C. Description of monument for corner and accessories established to perpetuate locating the position of the corner:

12

1/2" Iron rod and P.S. 21559 cap  
N58°W 66.77 ft., P.S. 21559 tag in 10" Maple (previous witness old tag grown over)  
N 73°W 67.28 ft., " " " in N. stem twin 12" Cedar ( previous witness, old tag grown over)  
N 40°E 56.01 ft., P.S.21559 tag in 5" stem of twin 5"-3" Cedar  
S 14°W 148.56 ft., P.S. 21559 tag in power pole

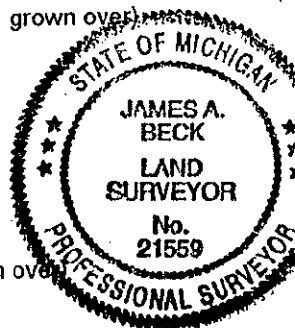

Signed by *James A. Beck*  
Surveyor's Michigan License No. 21559

Date 12/18/1997

12 PART "A" CONTINUED

March 26, 1981 P.A. 74 (Land Corner Recordation) Certificate page 526 by Ronald Bischer Reg. No. 22428

Part A: No entry

Part B: "Set 1/2" Rod by S.P.

Reset corner by S.P. in accordance  
with Survey by R. Alanen, R.L.S."

Part C: " 1/2" Rod & RLS Cap.

N55°W 67.05' 7" Maple

N72°W 67.49' 9" Cedar

N76°E 49.51' 5" Cedar

June 30, 1984 P.A. 132 Survey Certificate by James A. Beck Reg. No. 21559

" West 1/4 Corner

N 55°W 67.05' 7" Maple

N 72°W 67.49' , 9" Cedar

N 76°E 49.51' , 5" Cedar

Oct. 11, 1990 P.A. 132 Survey Certificate by James A. Beck Reg No. 21559

"West 1/4 Cor Sec 2, T34N, R5E

1/2" iron

Witnesses:

N 55°W 67.05', 7" Maple

N 72°W 67.49', 9" Cedar

N 76°E 49.51', 5" Cedar