

JAN 14 1998

1997 PRESQUE ISLE COUNTY STATE OF MICHIGAN REMONUMENTATION SECTION

LAND CORNER RECORDATION CERTIFICATE Filing Requirement of Act 74, Mich. P.A. 1970

For corners in

Presque Isle

(County)

Located In:

Corner Code #

Belknap Twp.

1. Public Land Survey

T	34	R	5E	13
T		R		
T		R		
T		R		
S		T	R	
S		T	R	
S		T	R	
S		T	R	

2. Property Controlling in Section

3. Miscellaneous Property in Sec.

4. Lot No. \_\_\_\_\_, Recorded Plat \_\_\_\_\_  
5. Private Claims \_\_\_\_\_

LIBER 325 PAGE 091

PRESQUE ISLE COUNTY RECORDED

97 DEC 18 AM 9:56

*James M. Lamb*

REGISTER OF DEEDS

Register of Deeds Stamp & File Number

I, James A. Beck, in a field survey on Oct. 30, 1997 do hereby state that under requirements of P.A. 74, Michigan P.A. of 1970, the corner points mentioned in lines 1 and 2 above were in conformance with regulations and rules therefore as required in the current manual of survey instructions of the United States Department of the Interior, Bureau of Land Management or by a decree of a Court of Law and /or that the corner points mentioned in lines 3, 4 and 5 above were in conformance with the rules of the Michigan Board of Land Surveyors or by a Decree of a Court of Law; established, re-established, monumented, recovered, found as expressed below:

NOTE: Not more than 2 corners, all in the same town and range, may be recorded on this certificate.

	A	B	C	D	E	F	G	H	I	J	K	L	M
1													
2	6		5		4		3		2		1		
3									⊙				
4	7		8		9		10		11		12		
5													
6	10		17		16		15		14		13		
7													
8	19		20		21		22		23		24		
9													
10	30		29		28		27		26		25		
11													
12	31		32		33		34		35		36		
13													

A. Description of original monument and accessories and/or subsequent restoration:

- 13 1856 G.L.O. by Alfred Millerd
- "Set post Corner of Secs 2, 3, 10 & 11"
- Tamarack 10 N 47E 9
- Spruce 10 S 11W 24

SEE REVERSE SIDE OF CERTIFICATE FOR ADDITIONAL ACTIVITY AT CORNER

B. Description of corner evidence found and/or method applied in restoring or reestablishing corner:

- 13
- Found 1/2" iron, set P.S. 21559 cap on iron


Accessories:

- N 53°W 67.64 ft., P.S 21559 tag in 13" Pine ( old witness tag grown over)

Ratified by Peer Group in accordance with P.A. 345  
Chairman *Norman [Signature]*  
Date 11/13/97

C. Description of monument for corner and accessories established to perpetuate locating the position of the corner:

- 13 1/2" iron rod and P.S. 21559 cap
- Accessories:
- N 53°W 67.64 ft., P.S 21559 tag in 13" Pine ( old witness tag grown over)
- S 54°W 89.66 ft., P.S. 21559 tag in 12" Spruce
- S 57°E 66.19 ft. P.S. 21559 tag in power pole
- S 76°W 95.78 ft., P.S. 21559 tag in 7" Spruce
- Corner falls at center black top road North and South and center of gravel road East and West

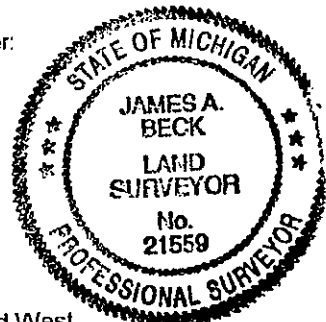

Signed by *James A. Beck*  
Surveyor's Michigan License No. 21559

Date 12/8/1997

PART "A" OF CERTIFICATE CONTINUED

I 3

Sep. 12, 1942 From page 32 County Surveyors Notes in Book labeled "Established Section Corners" located in the Register of Deeds vault in Presque Isle County Court House.  
Entry by G.F. DeLamater Reg. No. 2674  
"September 2, 1942 Survey for Mrs. Barbara Petit"  
SE Cor. Sec 3  
"Found pipe in corner"  
Spike in Cedar 3 N55E 76.3  
Spike in Cedar 4 S37E 56.3

Sep. 28, 1978 From files of Porter's Survey ( copy of corner witness card )  
" Found 1 1/2" -2" pipe in center of road E&W and N&S with banged (flared) up top"  
Witnesses:  
S 57°E 66.53' P pole  
S 51°W 58.34' 5" Spruce  
N 53°W 68.00' 7" Pine

Nov. 10, 1979 P.A. 74 ( Land Corner Recordation) Certificate page 439 by Herbert L. Fluharty Reg. No. 18223  
Part A: No entry  
Part B: "Set 5/8" x 18" iron w/RLS cap from witnesses from L.S. 15410,  
2' East of N-S CL on CL E-W Rd."  
Part C: "5/8 x 18" iron w/RLS cap; 7" Pine N53°W, 68.00'; 5" Spruce S51°W 58.34';  
P.P., S57°E 66.53'

240  
246  
247