

26099  
**1997 PRESQUE ISLE COUNTY STATE OF MICHIGAN REMONUMENTATION**

LAND CORNER RECORDATION CERTIFICATE  
 Filing Requirement of Act 74, Mich. P.A. 1970

LIBER **325** PAGE **093**

For corners in

Presque Isle (County)	Located In:	Corner Code #
	Belknap Twp.	
1. Public Land Survey	T 34N R 5E	14
	T ___ R ___	___
	T ___ R ___	___
	T ___ R ___	___
2. Property Controlling In Section	S ___ T ___ R ___	___
	S ___ T ___ R ___	___
3. Miscellaneous Property in Sec.	S ___ T ___ R ___	___
	S ___ T ___ R ___	___

PRESQUE ISLE COUNTY  
 RECORDED

97 DEC 18 AM 9:56

*James M. Starn*  
 REGISTER OF DEEDS

Register of Deeds Stamp & File Number

4. Lot No. \_\_\_\_\_, Recorded Plat \_\_\_\_\_  
 5. Private Claims \_\_\_\_\_

I, James A. Beck, in a field survey on Oct. 30, 1997 do hereby state that under requirements of P.A. 74, Michigan P.A. of 1970, the corner points mentioned in lines 1 and 2 above were in conformance with regulations and rules therefore as required in the current manual of survey instructions of the United States Department of the Interior, Bureau of Land Management or by a decree of a Court of Law and/or that the corner points mentioned in lines 3, 4 and 5 above were in conformance with the rules of the Michigan Board of Land Surveyors or by a Decree of a Court of Law; established, re-established, monumented, recovered, found as expressed below:

NOTE: Not more than 2 corners, all in the same town and range, may be recorded on this certificate.

	A	B	C	D	E	F	G	H	I	J	K	L	M
1													
2	6	5	4	3	2	1							
3													
4	7	8	9	10	11	12							
5													
6	18	17	16	15	14	13							
7													
8	19	20	21	22	23	24							
9													
10	30	29	28	27	26	25							
11													
12	31	32	33	34	35	36							
13													

A. Description of original monument and accessories and/or subsequent restoration:

14 1856 G.L.O. by Alfred Millerd  
 "Set qr. Section post"  
 B. Ash 12 N35W 33  
 Elm 12 S48E 31

SEE REVERSE SIDE OF CERTIFICATE  
 FOR ADDITIONAL ACTIVITY AT CORNER

B. Description of corner evidence found and/or method applied in restoring or reestablishing corner:

14 Found 1 -1/4" pipe set P.S. 21559 cap in pipe  
 N 14°W 87.72 ft., R.L.S.. 15410 ( Delmer Porter) tag in 6" Cedar

**SURVEY &  
 REMONUMENTATION**


**JAN 14 1998**

**SECTION**

C. Description of monument for corner and accessories established to perpetuate locating the position of the corner:

14 Found 1 -1/4" pipe set P.S. 21559 cap in pipe  
 N 14°W 87.72 ft., R.L.S.. 15410 ( Delmer Porter) tag in 6" Cedar  
 N 87°E 49.89 ft. P.S. 21559 tag in 16" Maple  
 N 85°W 40.61 ft. P.S. 21559 tag in 14" Maple  
 N 32°W 73.54 ft., P.S. 21559 tag in 4" Red Pine

Ratified by Peer Group  
 in accordance with P.A. 345  
 Chairman Norman J. [Signature]  
 Date 11/13/97

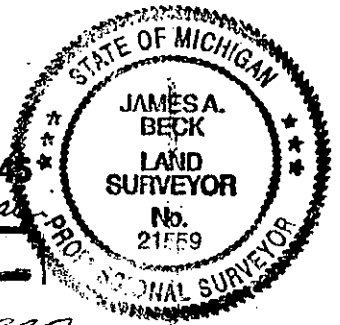

Signed by *James A. Beck*  
 Surveyor's Michigan License No. 21559

Date 12/8/1997

Nov. 9, 1979 P.A. 74 ( Land Corner Recordation) Certificate page 418 by Delmer E. Porter, Reg. No. 15410

Part A: No entry

Part B: "Found P.K. Nail in road center line on old fence line"

Part C: "Conc. Mon./Brass Cap

N54°E 32.40 4" Cedar

N87°E 44.89 14" Maple

N85°W 40.61 12" Maple

March 29, 1982 P.A. 74 ( Land Corner Recordation) Certificate page 546 by Ronald R. Bischer, Reg. No. 22428

Part A: No entry

Part B: "Found 1 1/4" Pipe"

Part C: " 1 1/2" Pipe"

N 14°W 87.72' 4" Cedar

N87°E 49'89' 14" Maple

N 85°W 40.61' 12" Maple