

2611

1997 PRESQUE ISLE COUNTY STATE OF MICHIGAN REMONUMENTATION

LAND CORNER RECORDATION CERTIFICATE
Filing Requirement of Act 74, Mich. P.A. 1970

LIBER 325 PAGE 097

For corners in

<u>Presque Isle</u> (County)	Located in:	Corner Code #
	<u>Belknap Twp.</u>	
1. Public Land Survey	T <u>34N</u> R <u>5E</u>	<u>16</u>
	T ___ R ___	___
	T ___ R ___	___
	T ___ R ___	___
2. Property Controlling in Section	S ___ T ___ R ___	___
	S ___ T ___ R ___	___
3. Miscellaneous Property in Sec.	S ___ T ___ R ___	___
	S ___ T ___ R ___	___

PRESQUE ISLE COUNTY
RECORDED

27 DEC 18 AM 9:56

Janet M. Schmidt
REGISTER OF DEEDS

Register of Deeds Stamp & File Number

4. Lot No. _____, Recorded Plat _____
5. Private Claims _____

I, James A. Beck, in a field survey on Oct. 30, 1997 do hereby state that under requirements of P.A. 74, Michigan P.A. of 1970, the corner points mentioned in lines 1 and 2 above were in conformance with regulations and rules therefore as required in the current manual of survey instructions of the United States Department of the Interior, Bureau of Land Management or by a decree of a Court of Law and /or that the corner points mentioned in lines 3, 4 and 5 above were in conformance with the rules of the Michigan Board of Land Surveyors or by a Decree of a Court of Law; established, re-established, monumented, recovered, found as expressed below:

NOTE: Not more than 2 corners, all in the same town and range, may be recorded on this certificate.

	A	B	C	D	E	F	G	H	I	J	K	L	M
1													
2	6		5		4		3		2		1		
3													
4	7		8		9		10		11		12		
5													
6	18		17		16		15		14		13		
7													
8	19		20		21		22		23		24		
9													
10	30		29		28		27		26		25		
11													
12	31		32		33		34		35		36		
13													

A. Description of original monument and accessories and/or subsequent restoration:

16 1856 G.L.O. by Alfred Millerd
"Set of Section post"
Sugar 12 N48°E 57
Sugar 12 S46°W 13

SEE REVERSE SIDE OF CERTIFICATE
FOR ADDITIONAL ACTIVITY AT CORNER

SURVEY &
REMONUMENTATION

JAN 14 1998

B. Description of corner evidence found and/or method applied in restoring or reestablishing corner:

16 Monument found:
1/2" iron rod and RLS 15410 (Delmer Porter) cap in monument box
Witnesses:
S 72°E 55.89 feet, old witness, multi- stem Maple


SECTION

Ratified by Peer Group
in accordance with P.A. 345
Chairman *James A. Beck*
Date *12/13/97*

SEE REVERSE SIDE FOR CONTINUATION PART "B"

C. Description of monument for corner and accessories established to perpetuate locating the position of the corner:

16 1/2" iron rod and RLS 15410 (Delmer Porter) cap in monument box
Witnesses:
N 40°E 41.83 feet, P.S. 21559 tag in multi-stem Maple, old witness, tag grown over
S 88°W 36.73 feet, P.S. 21559 tag in power pole
S 72°E 55.89 feet, old witness, multi- stem Maple, P.S. 21559 tag
S 60°E 42.11 feet, P.S. 21559 tag in power pole
East 32 feet, fence post lying down
S 65°W 1.70 feet, found P.K. nail as per field notes by James L. Scott, Reg. No. 8318
relative to survey dated Oct. 20, 1972 referred to above.

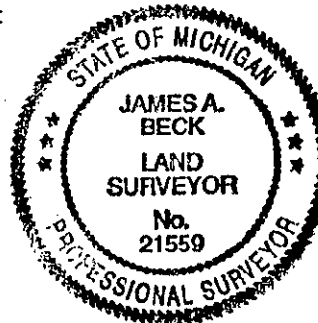

Signed by *James A. Beck*
Surveyor's Michigan License No. *21559*

Date *12/8/1997*

PART "A" OF CERTIFICATE CONTINUED LIBER 325 PAGE 098

Oct. 20, 1972 P.A. 132 Survey Certificate by James L. Scott Reg. No. 8318 Recorded in Liber 199 on Page 783
"W 1/4 Cor. Section 14"

Field notes as furnished by David Guthrie Reg. No. 22435 of Scott Engineering
contain the following information

"W 1/4 Cor. set PK. Nail by splitting Fe lines"

S 88°W P.Pole 35.11'

S 85°E P.Pole 42.08'

Aug. 22 1978 P.A. 132 Survey Certificate by Delmer E. Porter Reg. No. 15410 Recorded in Liber 226, Page 469

" 1/2" Rod & Cap in Mon. Box"

N 40°E 42.41 20" Maple

S 88°W 36.72 P.Pole

S 72°E 56.85 Tree

Aug. 25, 1978 P.A. 74 (Land Corner Recordation) Certificate, page 312 by Ronald R. Bischer Reg. No. 22428

Part A. No entry

Part B. "Found 2" Pipe, Raised with 1/2" Rod, set Mon. Box"

Part C. " 1/2" Rod in Mon. Box"

S88°W 36.72' P. Pole

N40°E 42.41' 20" Maple

S73°E 56.85' Maple

Sep. 16, 1980 P.A. 132 Survey Certificate by Delmer E. Porter Reg. No. 15410 Recorded in Liber 237, Page 878

" 1/2" Rod & Cap in Mon. Box"

N 40°E 42.41' 20" Maple

S 88°W 36.72' P.Pole

S 72°E 56.85 Tree

PART "B" OF CERTIFICATE CONTINUED

Remonumentation by James A. Beck

P.S. 21559

Monument found:

1/2" iron rod and RLS 15410 (Delmer Porter) cap in monument box

Witnesses:

N 40°E 41.83 feet, P.S. 21559 tag in multi-stem Maple, old witness, tag grown over

S 88°W 36.73 feet, P.S. 21559 tag in power pole

S 72°E 55.89 feet, old witness, multi- stem Maple, P.S. 21559 tag

S 60°E 42.11 feet, P.S. 21559 tag in power pole

East 32 feet, fence post lying down

S 65°W 1.70 feet, found P.K. nail as per field notes by James L. Scott, Reg. No. 8318
relative to survey dated Oct. 20, 1972 referred to above.

Monument falls opposite old fence East and 1 ft. plus-minus Easterly
of centerline of paved road North-South