

2613

1997 PRESQUE ISLE COUNTY STATE OF MICHIGAN REMONUMENTATION

LAND CORNER RECORDATION CERTIFICATE
Filing Requirement of Act 74, Mich. P.A. 1970

LIBER 325 PAGE 100

For corners in

Presque Isle (County)	Located In:	Corner Code #
	Belknap Twp.	
1. Public Land Survey	T 34N R 5E	1 8
	T R	
	T R	
	T R	
2. Property Controlling in Section	S T R	
	S T R	
3. Miscellaneous Property in Sec.	S T R	
	S T R	

PRESQUE ISLE COUNTY
RECORDED

97 DEC 18 AM 9:56

Janet M. Smith
REGISTER OF DEEDS

Register of Deeds Stamp & File Number

4. Lot No. _____, Recorded Plat _____
5. Private Claims _____

I, James A. Beck, in a field survey on Oct. 30, 1997 do hereby state that under requirements of P.A. 74, Michigan P.A. of 1970, the corner points mentioned in lines 1 and 2 above were in conformance with regulations and rules therefore as required in the current manual of survey instructions of the United States Department of the Interior, Bureau of Land Management or by a decree of a Court of Law and /or that the corner points mentioned in lines 3, 4 and 5 above were in conformance with the rules of the Michigan Board of Land Surveyors or by a Decree of a Court of Law; established, re-established, monumented, recovered, found as expressed below:

NOTE: Not more than 2 corners, all in the same town and range, may be recorded on this certificate.

	A	B	C	D	E	F	G	H	I	J	K	L	M
1													
2	6		5		4		3		2		1		
3													
4	7		8		9		10		11		12		
5													
6	18		17		16		15		14		13		
7													
8	19		20		21		22		23		24		
9													
10	30		29		28		27		26		25		
11													
12	31		32		33		34		35		36		
13													

A. Description of original monument and accessories and/or subsequent restoration:

- 1 81856 G.L.O by Alfred Millerd
- " Set 1/4 Section post"
- Cedar 12 N60E 7
- Cedar 9 S55W 18

SURVEY &
REMONUMENTATION

JAN 14 1998

B. Description of corner evidence found and/or method applied in restoring or reestablishing corner:

SECTION


- 1 8 set 1/2" iron rod and P.S. 21559 cap by single proportionate method after searching for evidence of original corner

C. Description of monument for corner and accessories established to perpetuate locating the position of the corner:

- 1 8 1/2" iron rod and P.S. 21559 cap
- Accessories:
- N 13°E 25.67 ft., P.S. 21559 tag in 7" W. Birch
- N 65°E 3.79 ft. " " " " 5" Ash
- S 23°E 8.66 ft. " " " " 8"W. Birch
- S 67°W 4.18' " " " " 5" Balsam
- S 63°W 5.32 ft. " " " " 5" Balsam
- Corner falls in thick lowland area

Ratified by Peer Group
in accordance with P.A. 345

Chairman *Norman J. Ovan*
Date 1/13/97

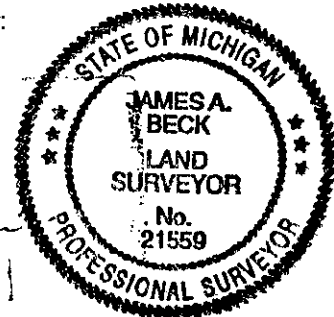

Signed by *James A. Beck*
Surveyor's Michigan License No. 21559

Date 12/8/1997