

2614

1997 PRESQUE ISLE COUNTY STATE OF MICHIGAN REMONUMENTATION.

LAND CORNER RECORDATION CERTIFICATE
Filing Requirement of Act 74, Mich. P.A. 1970

LIBER 325 PAGE 101

For corners in

Presque Isle

(County)

Located In:

Belknap Twp.

Corner Code #

1. Public Land Survey

T 34N R 5E

19

T _____ R _____

T _____ R _____

T _____ R _____

T _____ R _____

2. Property Controlling in Section

S _____ T _____ R _____

S _____ T _____ R _____

3. Miscellaneous Property in Sec.

S _____ T _____ R _____

S _____ T _____ R _____

PRESQUE ISLE COUNTY
RECORDED

97 DEC 18 AM 9:56

Janet M. Lamb
REGISTER OF DEEDS

Register of Deeds Stamp & File Number

4. Lot No. _____, Recorded Plat _____

5. Private Claims _____

I, James A. Beck, in a field survey on Oct. 30, 1997 do hereby state that under requirements of P.A. 74, Michigan P.A. of 1970, the corner points mentioned in lines 1 and 2 above were in conformance with regulations and rules therefore as required in the current manual of survey instructions of the United States Department of the Interior, Bureau of Land Management or by a decree of a Court of Law and /or that the corner points mentioned in lines 3, 4 and 5 above were in conformance with the rules of the Michigan Board of Land Surveyors or by a Decree of a Court of Law; established, re-established, monumented, recovered, found as expressed below:

NOTE: Not more than 2 corners, all in the same town and range, may be recorded on this certificate.

	A	B	C	D	E	F	G	H	I	J	K	L	M
1													
2		6		5		4		3		2		1	
3													
4		7		8		9		10		11		12	
5													
6		18		17		16		15		14		13	
7													
8		19		20		21		22		23		24	
9													
10		30		29		28		27		26		25	
11													
12		31		32		33		34		35		36	
13													

A. Description of original monument and accessories and/or subsequent restoration:

19 1856 G.L.O. by Alfred Millerd
"Set post Corner of Secs 22, 23, 26 & 27"
Hemlock 15 N75W 32
Cedar 10 S72E 31

SEE REVERSE SIDE FOR CONTINUATION

**SURVEY &
REMONUMENTATION**

JAN 14 1998

B. Description of corner evidence found and/or method applied in restoring or reestablishing corner:

19 found 1/2" iron rod, set P.S. 21559 cap

SECTION

Accessories:

S 70°W 26.89 ft., P.S. 21559 tag in 11" Maple (old tag is grown over)

Ratified by Peer Group
in accordance with P.A. 345

Chairman *Norman J. Quinn*

Date 11/13/97

C. Description of monument for corner and accessories established to perpetuate locating the position of the corner:

19 Monument:

1/2" iron rod, set P.S. 21559 cap

Accessories:


S 70°W 26.89 ft., P.S. 21559 tag in 11" Maple (old tag is grown over)

N 36°E 25.00 ft., P.S. 21559 tag in 10" Balsam

S 26°E 27.98 ft., P.S. 21559 tag in 3" Balsam

S 39°W 26.21 ft., P.S. 21559 tag in 6" Ash

Corner falls in thick underbrush at fallen fence post, wire running East and North

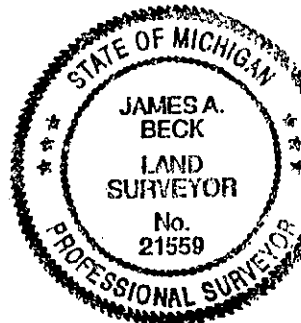

Signed by *James A. Beck*

Date 12/8/1997

Surveyor's Michigan License No. 21559

PART "A" OF CERTIFICATE CONTINUED

LIBER 325 PAGE 102

1856 G.L.O. by Alfred Millerd

"Set post Corner of Secs 22, 23, 26 & 27"
Hemlock 15 N75W 32
Cedar 10 S72E 31

Dec. 9, 1976 P.A. 132 Survey Certificate by Delmer E. Porter Reg. No. 15410 Recorded in Liber 215, Page 882

"NE Sec. Cor."
½" Rod @ Fe. Cor.
S 70°W 26.89' 6" Maple
N30°W 22.76' 6" Bal.

Dec. 20, 1976 P.A. 74 (Land Corner Recordtion) Certificate, page 168 by Ronald R. Bischer Reg. No. 22428

Part A. No entry
Part B. " set ½" Rod at Fe. Cor
Part C. " ½" Rod
S 70°W 26.89' 6" Balsam
N 30°W 22.76' 6" Balsam

Jan. 4, 1980 P.A. 132 Survey Certificate by Delmer E. Porter Reg. No. 15410 Recorded in Liber 234, Page 450

½" Rod @ Fe. Cor.
S 70°W 26.89' 6" Maple
N30°W 22.76' 6" Bal.

Mar 1986 P.A. 132 Survey Certificate by James A. Beck Reg. No. 21559 for Mr. & Mrs. Clayton Irish

SE Cor Sec. 22, T34N, R5E
"Fd. ½" rod @ fence cor"
S 70°W 26.89' 6" Maple
N 30°W 22.76' 6" Balsam Stump
East- Fence

March 28, 1986 P.A. 132 Survey Certificate by James A. Beck Reg. No. 21559 for Eldon Hempel

SE Cor Sec 22 T34N-R5E
" ½" Rod @ Fe. Cor."