

2616

1997 PRESQUE ISLE COUNTY STATE OF MICHIGAN REMONUMENTATION

LAND CORNER RECORDATION CERTIFICATE
Filing Requirement of Act 74, Mich. P.A. 1970

LIBER 325 PAGE 104

For corners in

Presque Isle

(County)

Located In:

Belknap Twp.

Corner Code #

1. Public Land Survey

T 34N R 5E I 11

T _____ R _____

T _____ R _____

T _____ R _____

2. Property Controlling in Section

S _____ T _____ R _____

S _____ T _____ R _____

3. Miscellaneous Property in Sec.

S _____ T _____ R _____

S _____ T _____ R _____

PRESQUE ISLE COUNTY
RECORDED

97 DEC 18 AM 9:57

Janet M. Shum
REGISTER OF DEEDS

Register of Deeds Stamp & File Number

4. Lot No. _____, Recorded Plat _____

5. Private Claims _____

I, James A. Beck, in a field survey on Oct. 30, 1997 do hereby state that under requirements of P.A. 74, Michigan P.A. of 1970, the corner points mentioned in lines 1 and 2 above were in conformance with regulations and rules therefore as required in the current manual of survey instructions of the United States Department of the Interior, Bureau of Land Management or by a decree of a Court of Law and/or that the corner points mentioned in lines 3, 4 and 5 above were in conformance with the rules of the Michigan Board of Land Surveyors or by a Decree of a Court of Law; established, re-established, monumented, recovered, found as expressed below:

NOTE: Not more than 2 corners, all in the same town and range, may be recorded on this certificate.

	A	B	C	D	E	F	G	H	I	J	K	L	M
1													
2		6		5		4		3		2		1	
3													
4		7		8		9		10		11		12	
5													
6		18		17		16		15		14		13	
7													
8		19		20		21		22		23		24	
9													
10		30		29		28		27		26		25	
11													
12		31		32		33		34		35		36	
13													

A. Description of original monument and accessories and/or subsequent restoration:

I 11 1856 G.L.O. by Alfred Millerd
" Set post Corner of Secs. 26, 27, 34 & 35"
Hemlock 24 S25W 20
Sugar 8 N25E 30

SEE REVERSE SIDE FOR CONTINUATION

SURVEY &
REMONUMENTATION

JAN 14 1998

B. Description of corner evidence found and/or method applied in restoring or reestablishing corner:

SECTION

I 11 Found brass cap set in cement cylinder (Presque Isle County monument)

N 87°E 64 ft + or -, leaning fence post
S 48°W 65 ft. + or -, leaning fence post


C. Description of monument for corner and accessories established to perpetuate locating the position of the corner:

I 11 Brass cap set in cement cylinder (Presque Isle County monument)

Accessories
N 87°E 64 ft + or -, leaning fence post
S 48°W 65 ft. + or -, leaning fence post
N 20°E 137.27 ft., P.S. 21559 tag in power pole
S 26°W 163.38 ft., " " " " "
S 60°W 60.09 ft., " " " " "
N 39°W 72.34 ft., " " " " "

Ratified by Peer Group
in accordance with P.A. 345

Chairman Norman J. [Signature]
Date 11/13/97

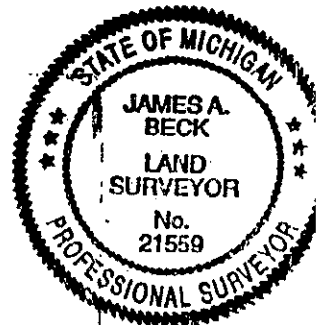

Corner falls at the Northerly extension of the center of a blacktop road South and at the center of gravel road to West

Signed by James A. Beck
Surveyor's Michigan License No. 21559

Date 12/8/1997

PART "A" OF CERTIFICATE CONTINUED LIBER 325 PAGE 105

Dec. 21, 1976 P.A.74 (Land Corner Recordation) Certificate page 167 by Ronald Bischer Reg. No. 22428

Part A. No entry

Part B. " Set ½" Rod from Scott's witnesses"

Part C. " ½" Rod"

N 87°E 63.97' Fe. Cor.

N 44°W 48.30' Fe. Cor

S 48°W 64.90' Fe. Post

Nov. 7, 1979 P.A.74 (Land Corner Recordation) Certificate page 418 by Delmer E. Porter, Reg. No. 15410

Part A. " ½" Rod "

N 87°E 63.97' Fe. Cor.

N 44°W 48.30' Fe. Cor

S 48°W 64.90' Fe. Post

Part B. " same as above"

Part C. " Conc. Mon./Brass Cap, witness same as above"