

2617

1997 PRESQUE ISLE COUNTY STATE OF MICHIGAN REMONUMENTATION

LAND CORNER RECORDATION CERTIFICATE Filing Requirement of Act 74, Mich. P.A. 1970

For corners in

Presque Isle (County)	Located In: Belknap Twp.	Corner Code #
1. Public Land Survey	T 34N R 5E	I 12
	T R	
	T R	
	T R	
2. Property Controlling in Section	S T R	
	S T R	
3. Miscellaneous Property in Sec.	S T R	
	S T R	

LIBER 325 PAGE 106

PRESQUE ISLE COUNTY
RECORDS

97 DEC 18 AM 9:57

John M. Seibert

REGISTER OF DEEDS

Register of Deeds Stamp & File Number

4. Lot No. _____, Recorded Plat _____
5. Private Claims _____

I, James A. Beck, in a field survey on Oct. 30, 1997 do hereby state that under requirements of P.A. 74, Michigan P.A. of 1970, the corner points mentioned in lines 1 and 2 above were in conformance with regulations and rules therefore as required in the current manual of survey instructions of the United States Department of the Interior, Bureau of Land Management or by a decree of a Court of Law and /or that the corner points mentioned in lines 3, 4 and 5 above were in conformance with the rules of the Michigan Board of Land Surveyors or by a Decree of a Court of Law; established, re-established, monumented, recovered, found as expressed below:

NOTE: Not more than 2 corners, all in the same town and range, may be recorded on this certificate.

	A	B	C	D	E	F	G	H	I	J	K	L	M
1													
2	6		5		4		3		2		1		
3													
4	7		8		9		10		11		12		
5													
6	18		17		16		15		14		13		
7													
8	19		20		21		22		23		24		
9													
10	30		29		28		27		26		25		
11													
12	31		32		33		34	⊙	35		36		
13													

A. Description of original monument and accessories and/or subsequent restoration:
 I 12 1856 G.L.O. by Alfred Millerd
 " Set qr. Sec. post"
 Sugar 10 N30W 10
 Beech 6 S60E 12

Sep. 22, 1978 P.A. 74 (Land Corner Recordation) Certificate page 167
 by Delmer E. Porter Reg. No. 15410
 Part A. " 1" pipe (Scott 1968)"
 S 60°W 40.75' 36" Maple
 S 30°E 52.60' Fe. Post
 Due East 31.85' Fe. Cor.
 Part B. " Set ½" Rod & Cap by Single Proportion"
 Part C. " ½" Rod & Cap in Mon. Box"
 N43°W 66.04' Fe. Post

B. Description of corner evidence found and/or method applied in restoring or reestablishing corner:
 I 12 :
 found ½" iron rod and P.S. 15410 cap in Monument Box
 (all previous witnesses gone)

SURVEY & REMONUMENTATION

JAN 14 1998


SECTION

C. Description of monument for corner and accessories established to perpetuate locating the position of the corner:
 I 12 ½" iron rod and P.S. 15410 cap in Monument Box
 Accessories:
 N 5°W 254.96 ft., P.S. 21559 tag in power pole
 S 41°E 48.34 ft., P.S. 21559 tag in 14" Maple
 S 34°W 61.76 ft., P.S. 21559 tag in 4" Maple
 S 29°E 135.11 ft., Southwest corner foundation
 Corner falls in North-South blacktop road.

Ratified by Peer Group
in accordance with P.A. 345

Chairman *William J. [Signature]*

Date 11/13/97

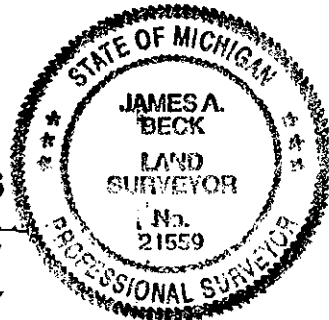

Signed by *James A. Beck*
 Surveyor's Michigan License No. 21559

Date 12/8/1997