

2645

1997 PRESQUE ISLE COUNTY, STATE OF MICHIGAN REMONUMENTATION

97 DEC 22 AM 9:55

LAND CORNER RECORDATION CERTIFICATE  
Filing Requirement of Act 74, Mich. P.A. 1970

*Janet M. Smith*  
REGISTER OF DEEDS

For corners in

Presque Isle  
(County)

Located In:

Corner Code #

1. Public Land Survey	T 34N 5E	J-1
	T R	
	T R	
	T R	
2. Property Controlling in Section	S T R	
	S T R	
3. Miscellaneous Property in Sec.	S T R	
	S T R	

Register of Deeds Stamp & File Number

4. Lot No. \_\_\_\_\_, Recorded Plat \_\_\_\_\_  
5. Private Claims \_\_\_\_\_

1	A	B	C	D	E	F	G	H	I	J	K	L	M
2	6	5	4	3	2	1							
3													
4	7	8	9	10	11	12							
5													
6	18	17	16	15	14	13							
7													
8	19	20	21	22	23	24							
9													
10	30	29	28	27	26	25							
11													
12	31	32	33	34	35	36							
13													

I, Ronald Bischer, in a field survey on Sept 11, 1997 do hereby state that under requirements of P.A. 74, Michigan P.A. of 1970, the corner points mentioned in lines 1 and 2 above were in conformance with regulations and rules therefore as required in the current manual of survey instructions of the United States Department of the Interior, Bureau of Land Management or by a decree of a Court of Law and/or that the corner points mentioned in lines 3, 4 and 5 above were in conformance with the rules of the Michigan Board of Land Surveyors or by a Decree of a Court of Law; established, re-established, monumented, recovered, found as expressed below:

NOTE: Not more than 2 corners, all in the same town and range, may be recorded on this certificate.

A. Description of original monument and accessories and/or subsequent restoration:

J-1  
GLO Notes  
John Hodgson  
1840 Survey  
Set Post  
Beech 7" N33° W 22 lks  
Sugar Maple 17" N81° E 22 lks

1974 Delmar Porter #15410  
Found conc. Mon. Set 2 witnesses  
1984 James Beck #21559  
three witnesses  
1993 Norman Quaine #33984  
Found Conc. Mon. and three witnesses


B. Description of corner evidence found and/or method applied in restoring or reestablishing corner:

J-1  
Found Conc. Mon. and Cap # 15410  
One Porter Witness  
Three Beck Witnesses

SURVEY &  
REMONUMENTATION

JAN 14 1998

SECTION

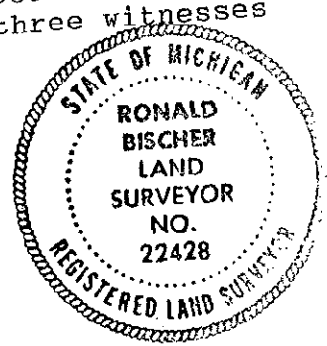

C. Description of monument for corner and accessories established to perpetuate locating the position of the corner:

J-1  
Conc. Mon and Cap #15410  
N03° E 39.81' steel Fence post  
N74° E 121.32' P. Pole  
S65° E 57.10' Fence Post  
S11° E 17.08' 4" Apple Tree

Porter Witness  
Beck witness  
Beck Witness  
Beck Witness

Ratified by Peer Group  
in accordance with P.A. 345  
Chairman *Norman Quaine*  
Date 10/30/97

Signed by Ronald R. Bischer  
Surveyor's Michigan License No. 22428

Date Oct. 10, 1997