

1997 PRESQUE ISLE COUNTY, STATE OF MICHIGAN REMONUMENTATION

LAND CORNER RECORDATION CERTIFICATE  
Filing Requirement of Act 74, Mich. P.A. 1970

DEC 22 AM 9:55

For corners in

Presque Isle (County)	Located In:	Corner Code #
1. Public Land Survey	T34NR 5E	J-3
	T R	
	T R	
	T R	
2. Property Controlling in Section	S T R	
	S T R	
3. Miscellaneous Property in Sec.	S T R	
	S T R	

*Janet M. Stamb*  
REGISTER OF DEEDS

Register of Deeds Stamp & File Number

4. Lot No. \_\_\_\_\_, Recorded Plat \_\_\_\_\_  
5. Private Claims \_\_\_\_\_

I, Ronald Bischer, in a field survey on Sept 11, 19 97 do hereby state that under requirements of P.A. 74, Michigan P.A. of 1970, the corner points mentioned in lines 1 and 2 above were in conformance with regulations and rules therefore as required in the current manual of survey instructions of the United States Department of the Interior, Bureau of Land Management or by a decree of a Court of Law and/or that the corner points mentioned in lines 3, 4 and 5 above were in conformance with the rules of the Michigan Board of Land Surveyors or by a Decree of a Court of Law; established, re-established, monumented, recovered, found as expressed below:

	A	B	C	D	E	F	G	H	I	J	K	L	M
1													
2	6	5	4	3	2	1							
3													
4	7	8	9	10	11	12							
5													
6	18	17	16	15	14	13							
7													
8	19	20	21	22	23	24							
9													
10	30	29	28	27	26	25							
11													
12	31	32	33	34	35	36							
13													


NOTE: Not more than 2 corners, all in the same town and range, may be recorded on this certificate.

A. Description of original monument and accessories and/or subsequent restoration:

J-3

GLO Notes  
Alfred Millerd  
1856 Resurvey  
Set Post  
Beech 12" N37° E 56 Lks  
Beech 8" S55° W 8 lks

1979 Delmer Porter #15410  
Found R/R Spike set Remon. Mon.  
and three witnesses

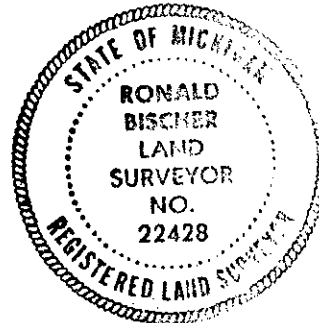

B. Description of corner evidence found and/or method applied in restoring or reestablishing corner:

J-3

Found Remon. Mon.  
and Two Porter witnesses

SURVEY &  
REMONUMENTATION

JAN 14 1998

SECTION

C. Description of monument for corner and accessories established to perpetuate locating the position of the corner:

J-3

Remon. Mon.  
N23° W 38.16' 8" Apple Tree  
North 58.34' 30" Maple  
S46° W 35.80' West end of culvert  
N55° E 126.25' Well Pump

PORTER WITNESS  
Porter witness

Ratified by Peer Group  
in accordance with P.A. 345  
Chairman *Sammy Durie*  
Date 10/30/97

Signed by Ronald R. Bischer  
Surveyor's Michigan License No. 22428

Date Oct. 10, 1997