

264

1997 PRESQUE ISLE COUNTY, STATE OF MICHIGAN REMONUMENTATION PRESQUE ISLE COUNTY RECORDED

LAND CORNER RECORDATION CERTIFICATE 97 DEC 22 AM 9:56  
Filing Requirement of Act 74, Mich. P.A. 1970

For corners in

<u>Presque Isle</u> (County)	Located In:	Corner Code #
1. Public Land Survey	T <u>34</u> N <u>R</u> <u>5</u> E	<u>J-5</u>
	T___R___	_____
	T___R___	_____
	T___R___	_____
2. Property Controlling in Section	S___T___R___	_____
	S___T___R___	_____
3. Miscellaneous Property in Sec.	S___T___R___	_____
	S___T___R___	_____

*Janet M. Lamb*  
REGISTER OF DEEDS

Register of Deeds Stamp & File Number

4. Lot No. \_\_\_\_\_, Recorded Plat \_\_\_\_\_  
5. Private Claims \_\_\_\_\_

I, Ronald Bischer, in a field survey on Sept 11, 1997 do hereby state that under requirements of P.A. 74, Michigan P.A. of 1970, the corner points mentioned in lines 1 and 2 above were in conformance with regulations and rules therefore as required in the current manual of survey instructions of the United States Department of the Interior, Bureau of Land Management or by a decree of a Court of Law and /or that the corner points mentioned in lines 3, 4 and 5 above were in conformance with the rules of the Michigan Board of Land Surveyors or by a Decree of a Court of Law; established, re-established, monumented, recovered, found as expressed below:

NOTE: Not more than 2 corners, all in the same town and range, may be recorded on this certificate.

1	A	B	C	D	E	F	G	H	I	J	K	L	M
2	6		5		4		3		2		1		
3													
4	7		8		9		10		11		12		
5										•			
6	18		17		16		15		14		13		
7													
8	19		20		21		22		23		24		
9													
10	30		29		28		27		26		25		
11													
12	31		32		33		34		35		36		
13													

A. Description of original monument and accessories and/or subsequent restoration:

J-5

GLO Notes	1972 James Scott #8318
Alfred Millerd	Iron North of fence
1856 Resurvey	
Set Post	
Fir 10" N08° W 19 lks	
Black Ash 10 " S15° E 3 ;1s	


B. Description of corner evidence found and/or method applied in restoring or reestablishing corner:

J-5  
Found 1/2" rod at Single proportion distance  
East 2622.03' - section corner  
West 2622.07' - section corner

SURVEY &  
REMONUMENTATION

JAN 14 1998

SECTION

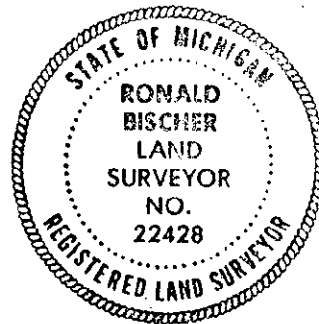

C. Description of monument for corner and accessories established to perpetuate locating the position of the corner:

J-5

1/2" Rod and Cap #22428

N76° E	106.44'	Power Pole with tag #15410	Porter
S57° E	61.32'	2" Cedar	
S62° E	71.22'	4" Apple tree	
S68 E	100.92'	4" Spruce	

Ratified by Peer Group  
in accordance with P.A. 345  
Chairman *William J. O'Brien*  
Date 10/30/97

Signed by Ronald R. Bischer Date Oct 8, 1997  
Surveyor's Michigan License No. 22428