

LAND CORNER RECORDATION CERTIFICATE
Filing Requirement of Act 74, Mich. P.A. 1970

97 DEC 22 AM 9:56

For corners in

<u>Presque Isle</u> (County)	Located In:	Corner Code #
1. Public Land Survey	T <u>34</u> N <u>5</u> E	<u>J-7</u>
	T ___ R ___	_____
	T ___ R ___	_____
	T ___ R ___	_____
2. Property Controlling in Section	S ___ T ___ R ___	_____
	S ___ T ___ R ___	_____
3. Miscellaneous Property in Sec.	S ___ T ___ R ___	_____
	S ___ T ___ R ___	_____

Jane M. Lamb
REGISTER OF DEEDS

Register of Deeds Stamp & File Number

4. Lot No. _____, Recorded Plat _____
5. Private Claims _____

I, Ronald Bischer, in a field survey on Sept 11, 1997 do hereby state that under requirements of P.A. 74, Michigan P.A. of 1970, the corner points mentioned in lines 1 and 2 above were in conformance with regulations and rules therefore as required in the current manual of survey instructions of the United States Department of the Interior, Bureau of Land Management or by a decree of a Court of Law and/or that the corner points mentioned in lines 3, 4 and 5 above were in conformance with the rules of the Michigan Board of Land Surveyors or by a Decree of a Court of Law; established, re-established, monumented, recovered, found as expressed below:

NOTE: Not more than 2 corners, all in the same town and range, may be recorded on this certificate.

	A	B	C	D	E	F	G	H	I	J	K	L	M
1													
2	6		5		4		3		2		1		
3													
4	7		8		9		10		11		12		
5													
6	18		17		16		15		14		13		
7													
8	19		20		21		22		23		24		
9													
10	30		29		28		27		26		25		
11													
12	31		32		33		34		35		36		
13													

A. Description of original monument and accessories and/or subsequent restoration:

J-7

GLO Notes
Alfred Millerd
1856 Resurvey
Set Post
Beech 10" N15° E 7 lks
Beech 6" S28° W 30 lks

1978 Ronald Bischer #22428
Set 1/2" rod in Mon. Box
and three witnesses

B. Description of corner evidence found and/or method applied in restoring or reestablishing corner:


J-7

Found 1/2" rod in Mon. box
and all three witnesses

SURVEY &
REMONUMENTATION

JAN 14 1998

SECTION

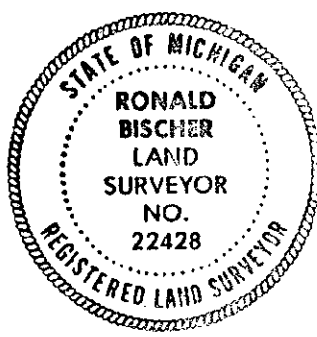

C. Description of monument for corner and accessories established to perpetuate locating the position of the corner:

J-7

1/2" Rod and Cap #22428 in Mon Box

S05° W 30.75' West end of Culvert
N36° E 51.65' Fence Post Bischer witness
N15° W 44.46' East gate post Bischer witness
N48° W 64.01' Fence post Bischer witness

Ratified by Peer Group
in accordance with P.A. 345
Chairman *Norman J. Quinn*
Date *10/30/97*

Signed by Ronald R. Bischer
Surveyor's Michigan License No. 22428

Date Oct 8, 1997