

264

LIBER 325 PAGE 144

PRESQUE ISLE COUNTY
RECORDED

1997 PRESQUE ISLE COUNTY, STATE OF MICHIGAN REMONUMENTATION

97 DEC 22 AM 9:56

LAND CORNER RECORDATION CERTIFICATE
Filing Requirement of Act 74, Mich. P.A. 1970

Janet M. Lamb
REGISTER OF DEEDS

For corners in

Presque Isle (County)	Located In:	Corner Code #
1. Public Land Survey	T34NR 5E	J-9
	T R	
	T R	
	T R	
2. Property Controlling in Section	S T R	
	S T R	
3. Miscellaneous Property in Sec.	S T R	
	S T R	

Register of Deeds Stamp & File Number

- 4. Lot No. _____, Recorded Plat _____
- 5. Private Claims _____

I, Ronald Bischer, in a field survey on Oct 1, 1997 do hereby state that under requirements of P.A. 74, Michigan P.A. of 1970, the corner points mentioned in lines 1 and 2 above were in conformance with regulations and rules therefore as required in the current manual of survey instructions of the United States Department of the Interior, Bureau of Land Management or by a decree of a Court of Law and /or that the corner points mentioned in lines 3, 4 and 5 above were in conformance with the rules of the Michigan Board of Land Surveyors or by a Decree of a Court of Law, established, re-established, monumented, recovered, found as expressed below:

NOTE: Not more than 2 corners, all in the same town and range, may be recorded on this certificate.

A	B	C	D	E	F	G	H	I	J	K	L	M
1												
2	6	5	4	3	2	1						
3												
4	7	8	9	10	11	12						
5												
6	18	17	16	15	14	13						
7												
8	19	20	21	22	23	24						
9												
10	30	29	28	27	26	25						
11												
12	31	32	33	34	35	36						
13												

A. Description of original monument and accessories and/or subsequent restoration:

J-9

GLO Notes
Alfred Millerd
1856 Resurvey
Set Wood Post
Sugar 7" S35° W 31 lks
Sugar 7" N45° E 21 lks

1979 Delmer Porter #15410
Set 1/2" Rod & Cap #15410
and three witnesses
1989 Norman Quaine #33984
Found 1/2" Rod and Cap #15410
and set three new witnesses

B. Description of corner evidence found and/or method applied in restoring or reestablishing corner:


J-9

Found 1/2" Rod & Cap #15410
Three Porter witnesses
and Three Quaine witnesses

SURVEY &
REMONUMENTATION

JAN 14 1998

SECTION

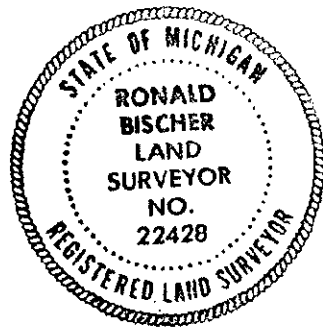

C. Description of monument for corner and accessories established to perpetuate locating the position of the corner:

J-9

1/2" Rod and Cap #15410

S37° E 95.61' NW corner of Cabin
S43° W 27.27' 8" Scotch Pine
N44° W 110.51' 12" Maple
N07° E 56.86' 12" Apple
South 43.24' 12" Scotch Pine
N51° E 26.36' 9" Aspen

Quaine witness
Quaine witness
Quaine witness
Porter witness
Porter witness
Porter witness

Ratified by Peer Group
in accordance with P.A. 34
Chairman *Norman J. Quaine*
Date 10/30/97

Signed by Ronald R. Bischer
Surveyor's Michigan License No. 22428

Date Oct 8, 1997