

1997 PRESQUE ISLE COUNTY, STATE OF MICHIGAN REMONUMENTATION

LAND CORNER RECORDATION CERTIFICATE
Filing Requirement of Act 74, Mich. P.A. 1970

For corners in
Presque Isle Located In: Corner Code #
(County)

1. Public Land Survey T 34N R 5E K-1
T _____ R _____
T _____ R _____
T _____ R _____

2. Property Controlling S _____ T _____ R _____
in Section S _____ T _____ R _____

3. Miscellaneous S _____ T _____ R _____
Property in Section S _____ T _____ R _____

PRESQUE ISLE COUNTY
RECORDED

97 DEC 22 AM 9:52

Janet M. Lamb
REGISTER OF DEEDS

Register of Deeds Stamp & File Number

4. Lot No. _____, Recorded Plat _____
5. Private Claims _____


	A	B	C	D	E	F	G	H	I	J	K	L	M
2	6		5		4		3		2				
3													
4	7		8		9		10		11		12		
5													
6	18		17		16		15		14		13		
7													
8	19		20		21		22		23		24		
9													
10	30		29		28		27		26		25		
11													
12	31		32		33		34		35		36		
13													

I, Ronald R. Bischer, a field survey on Sept. 8, 1997, do hereby certify that under requirements of P.A. 74, Michigan P.A. of 1970, the corner points mentioned in lines 1 and 2 above were in conformance with regulations and rules therefore as required in the current manual of survey instructions of the United States Department of the Interior, Bureau of Land Management or by a decree of a Court of Law and/or that the corner points mentioned in lines 3, 4 and 5 above were in conformance with the rules of the Michigan Board of Professional Surveyors or by a Decree of a Court of Law; established, re-established, monumented, re-monumented, recovered, found as expressed below:

NOTE: Not more than 4 corners, all in the same town and range, may be recorded on this certificate.

A. Description of original monument and accessories and/or subsequent restoration:

K-1
GLO Notes 1984 Survey by James Beck #21559
Alfred Millerd found 5/8" Rod
Resurvey 1856 Set 4 new Witnesses
Beech 12" S15° E 50 lks
Sugar 12" S15° W 65 lks

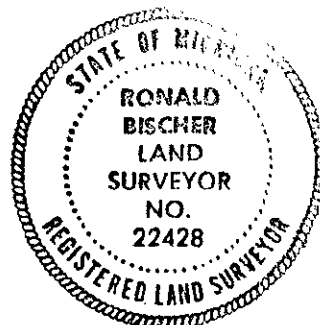

B. Description of corner evidence found and/or method applied in restoring or reestablishing corner:

K-1
found 5/8" Rod
and 3 Beck witnesses

SURVEY & REMONUMENTATION

JAN 14 1998

SECTION

C. Description of monument for corner and accessories established to perpetuate locating the position of the corner:

K-1
5/8" Rod and Cap #22428
N48° E 85.99' Power Pole
N64° W 63.31' 6" Maple Beck witness
S50° W 52.90' 8" Maple Beck witness
S87° E 38.08' 30" Maple Beck witness

Ratified by Peer Group
in accordance with P.A. 345
Chairman *William J. Quinn*
Date 10/30/97

Signed by Ronald R. Bischer Date Oct. 10, 1997
Surveyor's Michigan License No. 22428

224-97