

LAND CORNER RECORDATION CERTIFICATE

Filing Requirement of Act 74, Mich. P.A. 1970

PRESQUE ISLE COUNTY  
RECORDED

For corners in  
Presque Isle  
(County)

Located In:

Corner Code #

97 DEC 22 AM 9:52

*Jenit M. Lamb*  
REGISTER OF DEEDS

1. Public Land Survey	T	34N	R	5E	K-2
	T		R		
	T		R		
	T		R		
2. Property Controlling in Section	S		T	R	
	S		T	R	
3. Miscellaneous Property in Section	S		T	R	
	S		T	R	

Register of Deeds Stamp & File Number

4. Lot No. \_\_\_\_\_, Recorded Plat \_\_\_\_\_  
5. Private Claims \_\_\_\_\_

	A	B	C	D	E	F	G	H	I	J	K	L	M
2	6		5		4		3		2	•			
3													
4	7		8		9		10		11		12		
5													
6	18		17		16		15		14		13		
7													
8	19		20		21		22		23		24		
9													
10	30		29		28		27		26		25		
11													
12	31		32		33		34		35		36		
13													

I, Ronald Bischer, in a field survey on Sept. 8, 1997, do hereby certify that under requirements of P.A. 74, Michigan P.A. of 1970, the corner points mentioned in lines 1 and 2 above were in conformance with regulations and rules therefore as required in the current manual of survey instructions of the United States Department of the Interior, Bureau of Land Management or by a decree of a Court of Law and/or that the corner points mentioned in lines 3, 4 and 5 above were in conformance with the rules of the Michigan Board of Professional Surveyors or by a Decree of a Court of Law; established, re-established, monumented, re-monumented, recovered, found as expressed below:

NOTE: Not more than 4 corners, all in the same town and range, may be recorded on this certificate.


A. Description of original monument and accessories and/or subsequent restoration:  
K-2

GLO Notes  
Alfred Millerd  
Resurvey 1856  
Set post  
Hemlock 11" N38° E 24 lks  
Hemlock 14: S30° W 38 lks

1981 Ronald Bischer #22428  
Found 1" Pipe  
Set 4 witnesses  
1990 James Beck #21559  
1/2" pipe 4 new witnesses

B. Description of corner evidence found and/or method applied in restoring or reestablishing corner:  
K-2

Found 1/2" Rod and Cap #21559 and two Bischer witnesses

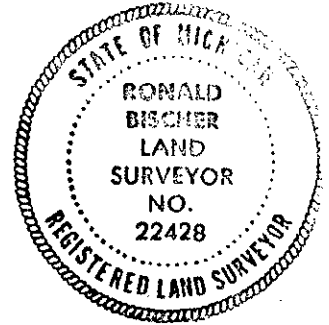

SURVEY & REMONUMENTATION

JAN 14 1998

SECTION

C. Description of monument for corner and accessories established to perpetuate locating the position of the corner:  
K-2

1/2" Rod and Cap #21559  
N14° E 124.32' R.O.W. Marker  
S67° W 89.40' Utility Pole  
S35° W 71.20' Utility Pole  
S23° E 120.53' Power pole  
North 17.3' Centerline U.S. 23

Ratified by Peer Group in accordance with P.A. 345  
Chairman *[Signature]*  
Date 10/30/97

old Bischer witness  
old Bischer witness

Signed by Ronald P. Bischer  
Surveyor's Michigan License No. 22428

Date Oct. 8, 1997