

1997 PRESQUE ISLE COUNTY, STATE OF MICHIGAN REMONUMENTATION

LAND CORNER RECORDATION CERTIFICATE  
Filing Requirement of Act 74, Mich. P.A. 1970

For corners in  
Presque Isle  
(County)

Located in:

Corner Code #

1. Public Land Survey	T 34N R 5E	K-3
	T _____ R _____	_____
	T _____ R _____	_____
	T _____ R _____	_____
2. Property Controlling in Section	S _____ T _____ R _____	_____
	S _____ T _____ R _____	_____
3. Miscellaneous Property in Section	S _____ T _____ R _____	_____
	S _____ T _____ R _____	_____

PRESQUE ISLE COUNTY  
REGISTERED

97 DEC 22 AM 9:52

*Janet M. Lamb*  
REGISTER OF DEEDS

Register of Deeds Stamp & File Number

4. Lot No. \_\_\_\_\_, Recorded Plat \_\_\_\_\_  
5. Private Claims \_\_\_\_\_

A	B	C	D	E	F	G	H	I	J	K	L	M
2	6	5	4	3	2							
3												
4	7	8	9	10	11	12						
5												
6	18	17	16	15	14	13						
7												
8	19	20	21	22	23	24						
9												
10	30	29	28	27	26	25						
11												
12	31	32	33	34	35	36						
13												

I, Ronald Bischer, in a field survey on Sept 8,, 1997, do hereby certify that under requirements of P.A. 74, Michigan P.A. of 1970, the corner points mentioned in lines 1 and 2 above were in conformance with regulations and rules therefore as required in the current manual of survey instructions of the United States Department of the Interior, Bureau of Land Management or by a decree of a Court of Law and/or that the corner points mentioned in lines 3, 4 and 5 above were in conformance with the rules of the Michigan Board of Professional Surveyors or by a Decree of a Court of Law; established, re-established, monumented, re-monumented, recovered, found as expressed below:

NOTE: Not more than 4 corners, all in the same town and range, may be recorded on this certificate.

A. Description of original monument and accessories and/or subsequent restoration:

K-3

GLO Notes

Alfred Millerd

Resurvey 1856

Set post

Beech 11" S42° E 24 lks

Beech 14" N50° W 55 lks

1972 Reino Alanen #12042

set 5/8" Rod and 3 witnesses

1978 Delmer Porter #15410

Set 5/8" rod in Mon. box and 3 witnesses

B. Description of corner evidence found and/or method applied in restoring or reestablishing corner:


K-3

Found 5/8" Rod in Mon. Box  
found one Alanen witness  
and one Porter witness

SURVEY &  
REMONUMENTATION

JAN 14 1998

SECTION

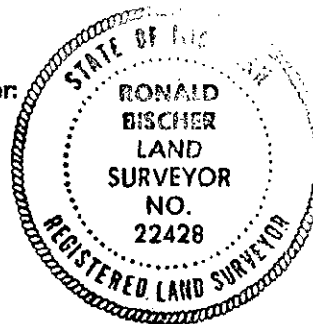

C. Description of monument for corner and accessories established to perpetuate locating the position of the corner:

K-3

5/8" Rod and Cap #22428 in Mon. Box

S69° W 63.65' Stop sign  
East 49.60' Power Pole  
N54° W 49.31' Road sign  
N50° W 46.55' Power Pole

Ratified by Peer Group  
in accordance with P.A. 345

Chairman *Edward Porter*

Date 10/30/97

Porter and Alanen witness

Signed by Ronald E. Bischer

Date Oct. 8, 1997

Surveyor's Michigan License No. 22428