

2635

LAND CORNER RECORDATION CERTIFICATE
Filing Requirement of Act 74, Mich. P.A. 1970

Table with columns: For corners in Presque Isle (County), Located In:, Corner Code #. Rows include Public Land Survey, Property Controlling in Section, and Miscellaneous Property in Section.

PRESQUE ISLE COUNTY RECORDED

97 DEC 22 AM 9:53

Janet M. Smith REGISTER OF DEEDS

Register of Deeds Stamp & File Number

4. Lot No. , Recorded Plat
5. Private Claims

Grid table with columns A-M and rows 1-13. A dot is marked at the intersection of column K and row 4.

Ronald Bischer, in a field survey on Sept. 9, 1997, do hereby certify that under requirements of P.A. 74, Michigan P.A. of 1970, the corner points mentioned in lines 1 and 2 above were in conformance with regulations and rules therefore as required in the current manual of survey instructions of the United States Department of the Interior, Bureau of Land Management or by a decree of a Court of Law and/or that the corner points mentioned in lines 3, 4 and 5 above were in conformance with the rules of the Michigan Board of Professional Surveyors or by a Decree of a Court of Law; established, re-established, monumented, re-monumented, recovered, found as expressed below:

NOTE: Not more than 4 corners, all in the same town and range, may be recorded on this certificate.

A. Description of original monument and accessories and/or subsequent restoration:

K-4

GLO Notes 1972 Reino Alanen #12042
Alfred Millerd Set 5/8" Rod and 2 witnesses
Resurvey 1856
Set post 1978 Delmer Porter #15410
Sugar 10" N30° E 13 lks Set 5/8" rod in Mon. Box
Beech 10" S40° W 17 lks and three witnesses

B. Description of corner evidence found and/or method applied in restoring or reestablishing corner:


K-4

Found 5/8" rod in Mon Box
one Alanen witness
two Porter witnesses

SURVEY & REMONUMENTATION

JAN 14 1998

SECTION

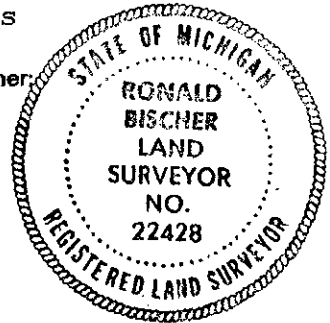

C. Description of monument for corner and accessories established to perpetuate locating the position of the corner:

K-4

5/8" Rod and cap # 22428 in Mon Box
N53° E 56.57' Tele. Cable box
S50° E 49.30' Road sign
N69° W 73.89' 18" Apple tree Porter witness
N58° E 64.28' Power Pole Porter and Alanen witness

Ratified by Peer Group in accordance with P.A. 345
Chairman [Signature]
Date 10/30/97

Signed by Ronald R. Bischer
Surveyor's Michigan License No. 22428

Date Oct. 8, 1997