

LAND CORNER RECORDATION CERTIFICATE
Filing Requirement of Act 74, Mich. P.A. 1970

97 DEC 22 AM 9:55

For corners in Presque Isle (County) Located In: Corner Code #
1. Public Land Survey T 34N R 5E K-6
2. Property Controlling in Section S T R
3. Miscellaneous Property in Section S T R
4. Lot No. , Recorded Plat
5. Private Claims

Janet M. Lamb
REGISTER OF DEEDS

Register of Deeds Stamp & File Number

Grid table with columns A-M and rows 1-13. A dot is present at row 6, column K.


I, Ronald Bischer, in a field survey on Sept 10, 1997, do hereby certify that under requirements of P.A. 74, Michigan P.A. of 1970, the corner points mentioned in lines 1 and 2 above were in conformance with regulations and rules therefore as required in the current manual of survey instructions of the United States Department of the Interior, Bureau of Land Management or by a decree of a Court of Law and/or that the corner points mentioned in lines 3, 4 and 5 above were in conformance with the rules of the Michigan Board of Professional Surveyors or by a Decree of a Court of Law; established, re-established, monumented, re-monumented, recovered, found as expressed below:

NOTE: Not more than 4 corners, all in the same town and range, may be recorded on this certificate.

A. Description of original monument and accessories and/or subsequent restoration: K-6

GLO Notes
Alfred Millerd
1856 Resurvey
Yellow Birch 10" S83° E 171ks
Sugar Maple 10" West 181ks

1978 Ronald Bischer #22428
Set 1/2" Rod in Mon. Box
and three witnesses

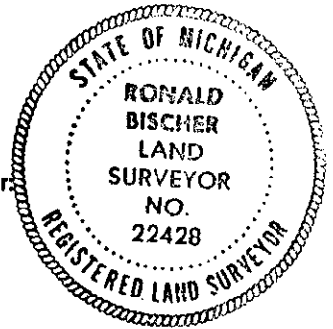

B. Description of corner evidence found and/or method applied in restoring or reestablishing corner: K-6

Found 1/2" Rod and Cap #22428
in Mon Box
all three Bischer witnesses

SURVEY &
REMONUMENTATION

JAN 14 1998

SECTION

C. Description of monument for corner and accessories established to perpetuate locating the position of the corner: K-6

1/2" Rod and Cap #22428 in Mon. Box

N82° W 42.97' 5" Apple Tree
S38° E 93.79' Power Pole old Bischer witness
S82° E 36.42' 13" Maple old Bischer witness
N45° E 42.58' 16" Maple old Bischer Witness

Ratified by Peer Group
in accordance with P.A. 345
Chairman [Signature]
Date 10/30/97

Signed by Ronald R. Bischer
Surveyor's Michigan License No. 22428

Date Oct. 8, 1997