

PRESQUE ISLE COUNTY
RECORDED

LAND CORNER RECORDATION CERTIFICATE
Filing Requirement of Act 74, Mich. P.A. 1970

97 DEC 22 AM 9:55

For corners in Presque Isle (County) Located In: Corner Code #

1. Public Land Survey	T	34N	R	5E	K-7
	T		R		
	T		R		
	T		R		
2. Property Controlling in Section	S		T	R	
	S		T	R	
3. Miscellaneous Property in Section	S		T	R	
	S		T	R	

4. Lot No. _____, Recorded Plat _____
5. Private Claims _____

Janet M. Lamb
REGISTER OF DEEDS

Register of Deeds Stamp & File Number


I, Ronald Bischer, in a field survey on Sept 10, 19 97, do hereby certify that under requirements of P.A. 74, Michigan P.A. of 1970, the corner points mentioned in lines 1 and 2 above were in conformance with regulations and rules therefore as required in the current manual of survey instructions of the United States Department of the Interior, Bureau of Land Management or by a decree of a Court of Law and/or that the corner points mentioned in lines 3, 4 and 5 above were in conformance with the rules of the Michigan Board of Professional Surveyors or by a Decree of a Court of Law; established, re-established, monumented, re-monumented, recovered, found as expressed below:

A	B	C	D	E	F	G	H	I	J	K	L	M
2	6	5	4	3	2	1						
3												
4	7	8	9	10	11	12						
5												
6	18	17	16	15	14	13						
7												
8	19	20	21	22	23	24						
9												
10	30	29	28	27	26	25						
11												
12	31	32	33	34	35	36						
13												

NOTE: Not more than 4 corners, all in the same town and range, may be recorded on this certificate.

A. Description of original monument and accessories and/or subsequent restoration:

K-7
GLO Notes
Alfred Millerd
1856 Resurvey
set Post
Beech 15" S55° E 7 lks
Sugar Maple 10" N65° W 35 lks
1977 Delmar Porter #15410
Set 1/2" Rod in Mon. box
and three witness

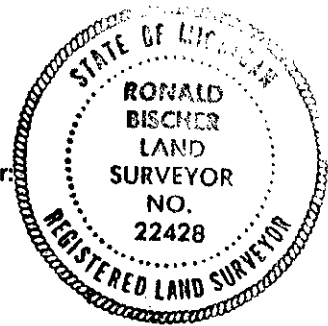

B. Description of corner evidence found and/or method applied in restoring or reestablishing corner:

K-7
Found 1/2" rod and cap #22428 in mon box
and two Porter witnesses

SURVEY & REMONUMENTATION

JAN 14 1998

SECTION

C. Description of monument for corner and accessories established to perpetuate locating the position of the corner:

K-7
1/2" rod and cap #22428 in Mon. box
N56° W 62.30' 12" Norway Porter witness
N63° W 77.70' 20" Chestnut Porter witness
S33° E 72.88' NW Corner of Building
N55° E 62.19' Tele. Cable Box

Ratified by Peer Group
in accordance with P.A. 345
Chairman *Norman J. [Signature]*
Date 10/30/97

Signed by Ronald R. Bischer Date Oct. 8, 1997
Surveyor's Michigan License No. 22428